



# PRINCIPAL PARTICULARS


LENGTH O.A. ----- 36.00 M  
 LENGTH B.P. ----- 33.20 M  
 BREADTH MLD. ----- 7.60 M  
 DEPTH MLD. ----- 3.65 M  
 DESIGN DRAFT ----- 1.88 M  
 COMPLEMENT ----- 8 CREW  
                               70 OFFSHORE WORKERS

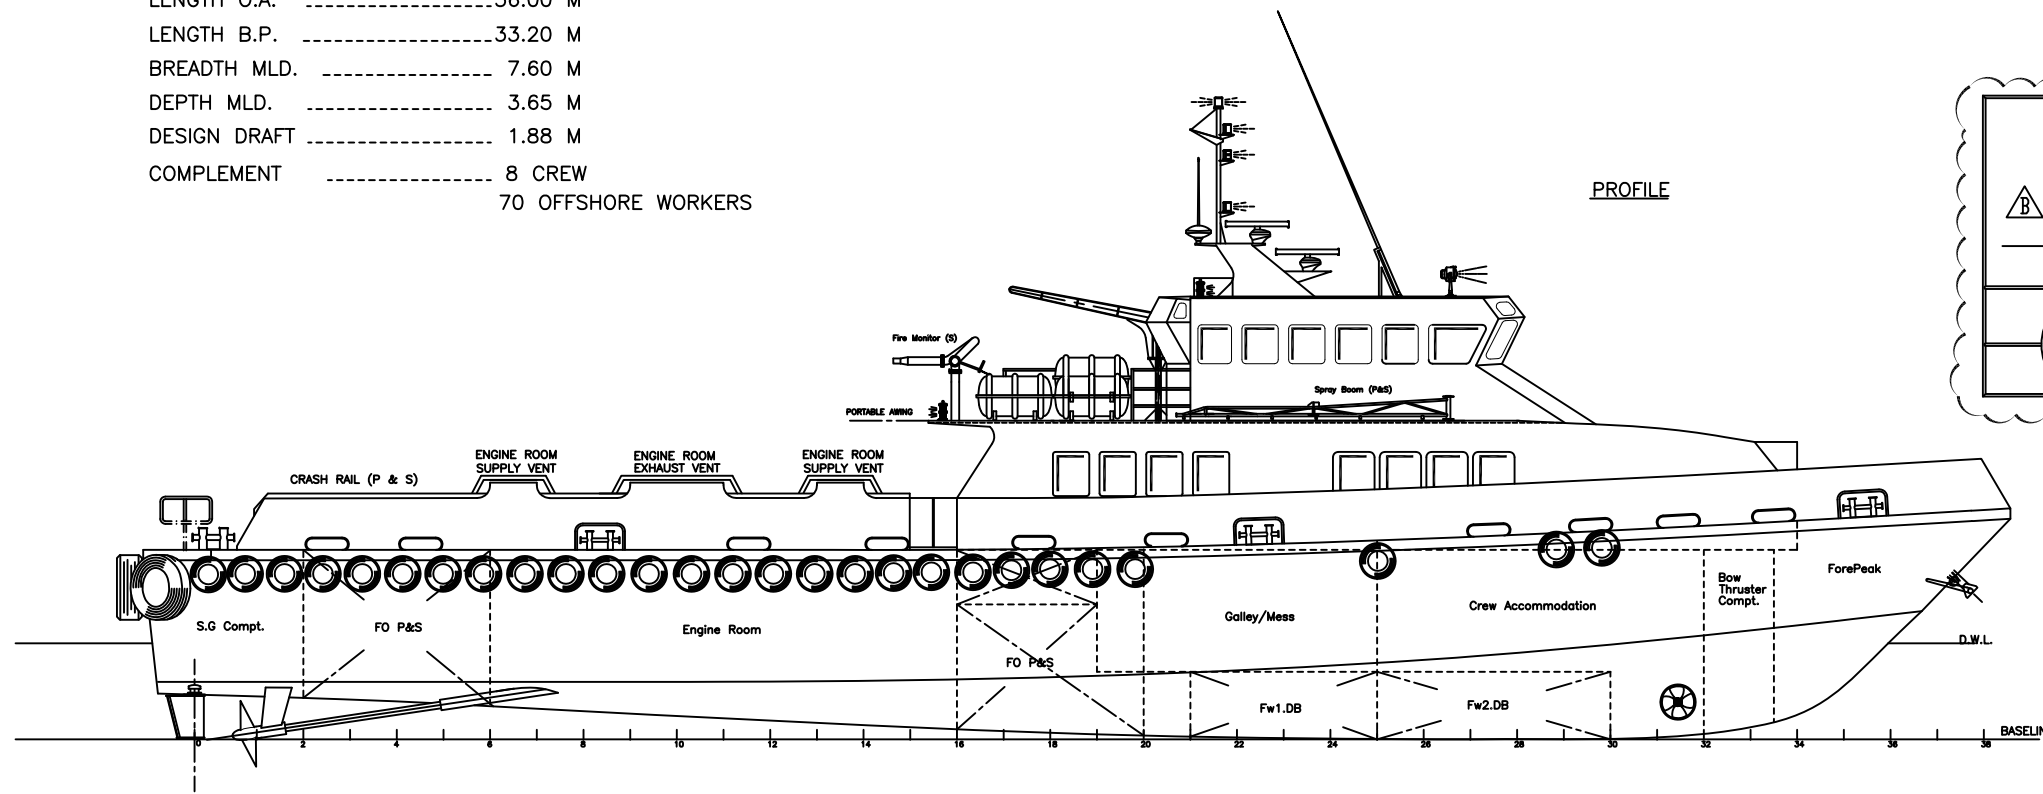


PROFILE

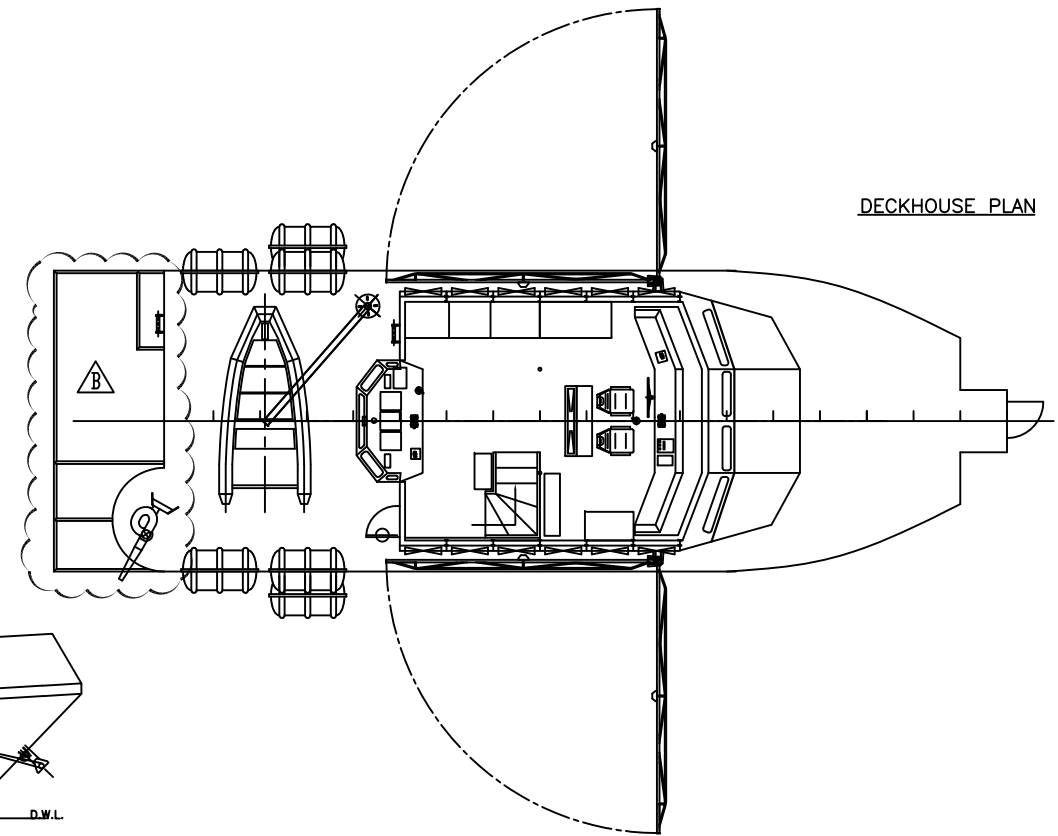


DECKHOUSE PLAN

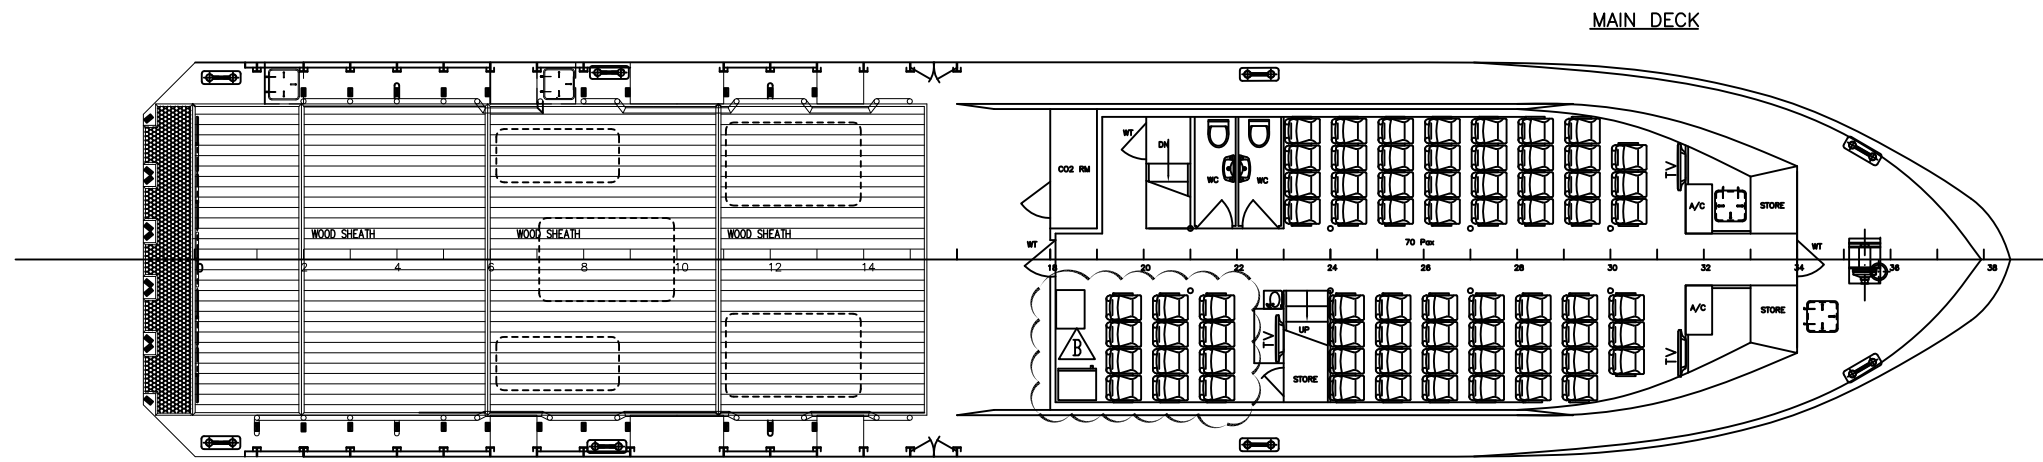

MAIN DECK

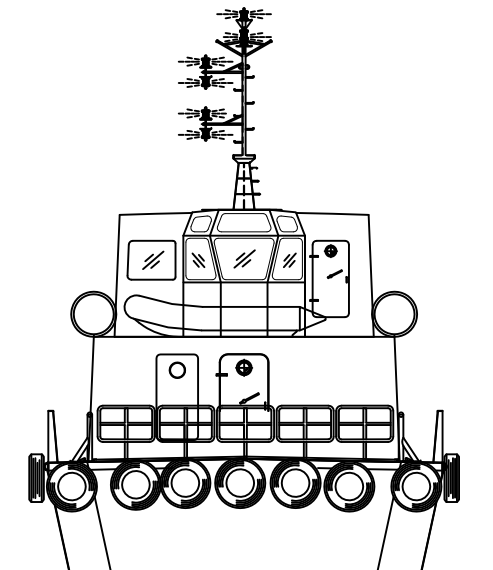

STERN VIEW

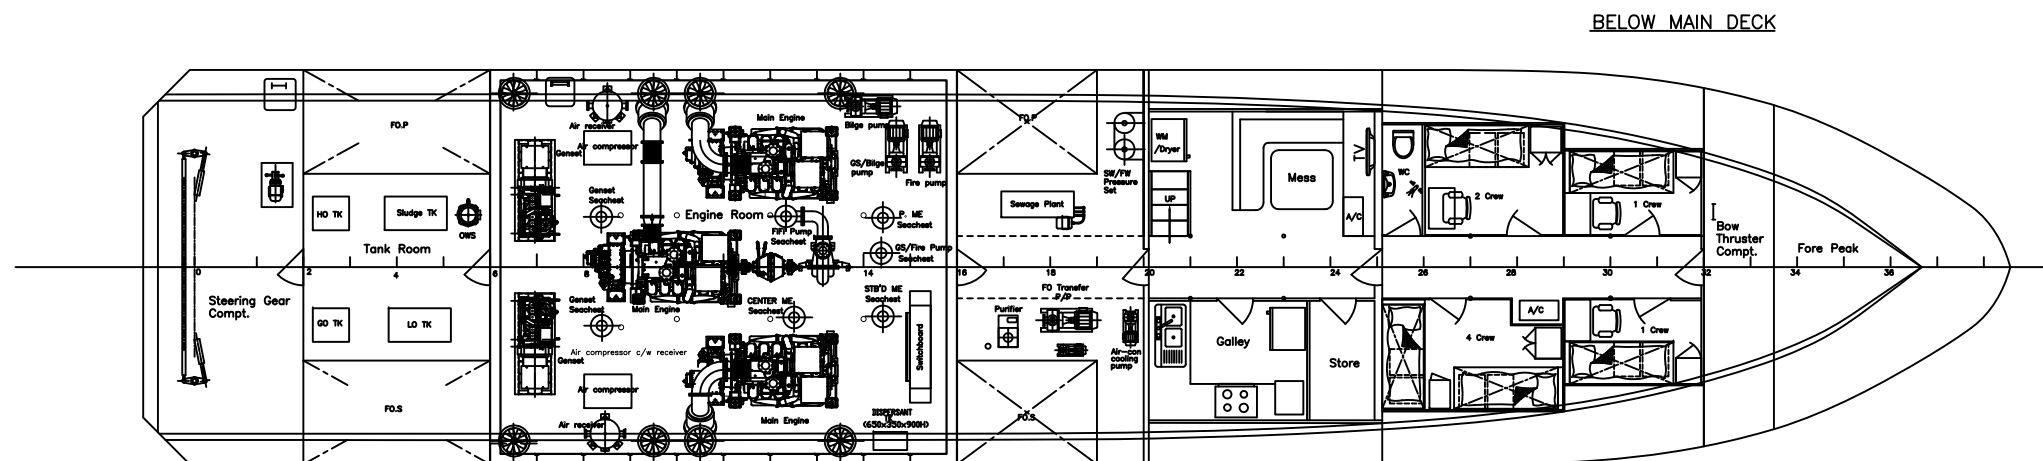

BELOW MAIN DECK

B	AS BUILT	24,MAY,10	ZH	
Rev No	Modification	Date	Done	Remark
PROJECT: 36M CREW BOAT (H163)				
TITLE: GENERAL ARRANGEMENT				
<b>PENGUIN SHIPYARD INTERNATIONAL PTE LTD</b> 18 Tuas Basin Link, Singapore 638784 Tel: 68628322 Fax: 68622150				
DRAWN: ZH	DATE: 13,AUG,2008	SCALE: 1:75		
CHECKED: BWB	DATE:	REVISION: A		
DRAWING No.: PBIL-H162-G-01		SHEET: 1 OF 1		