

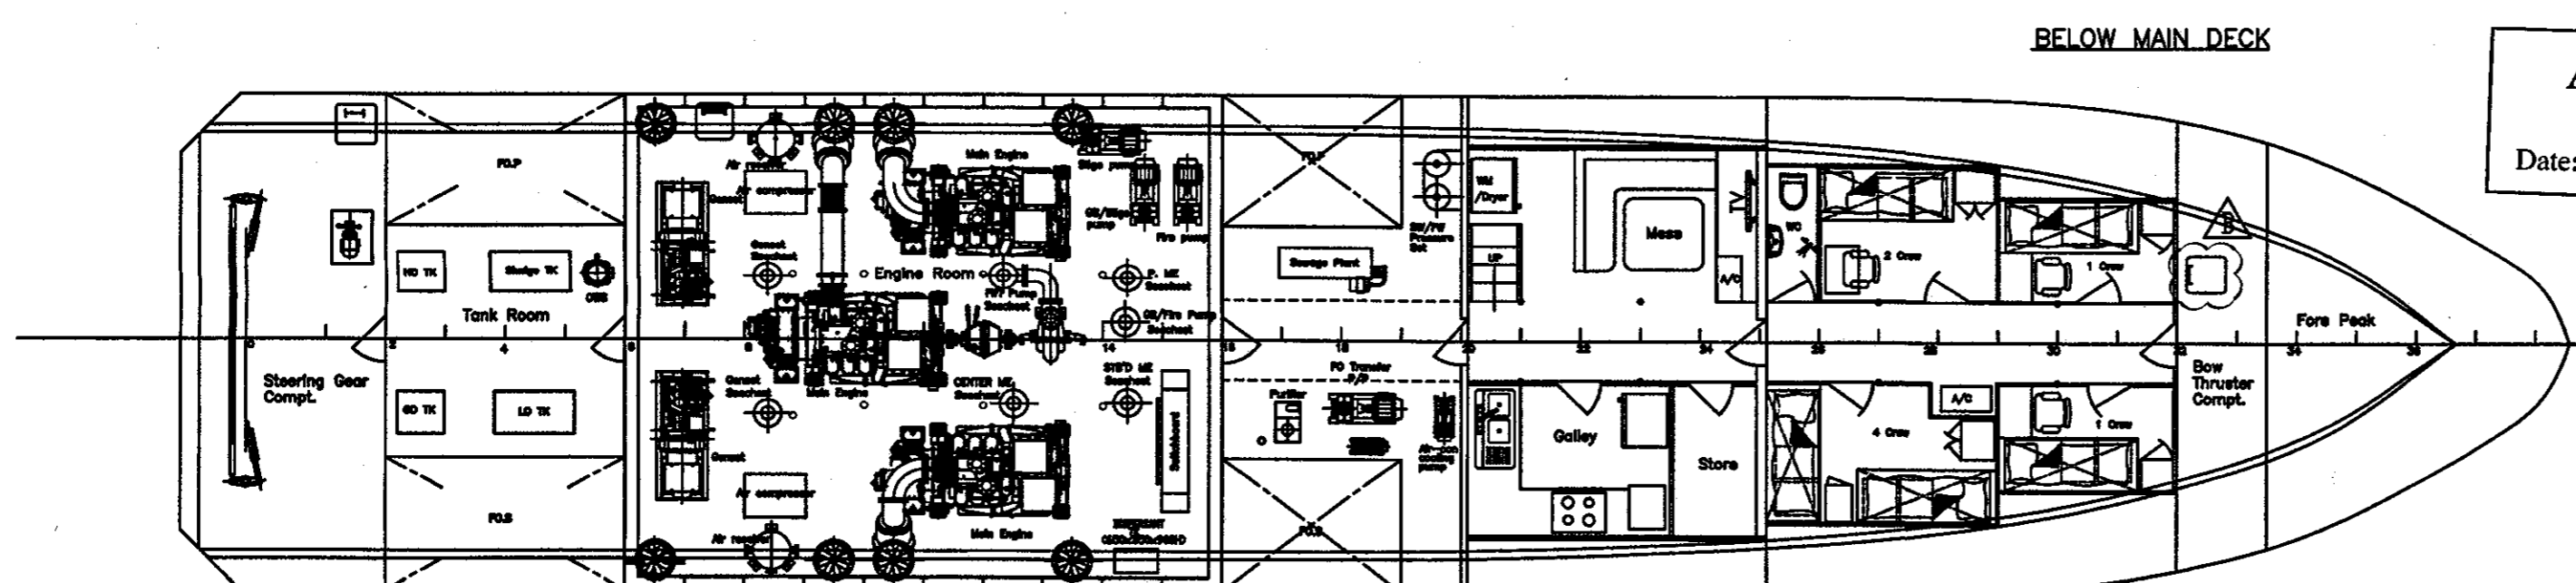
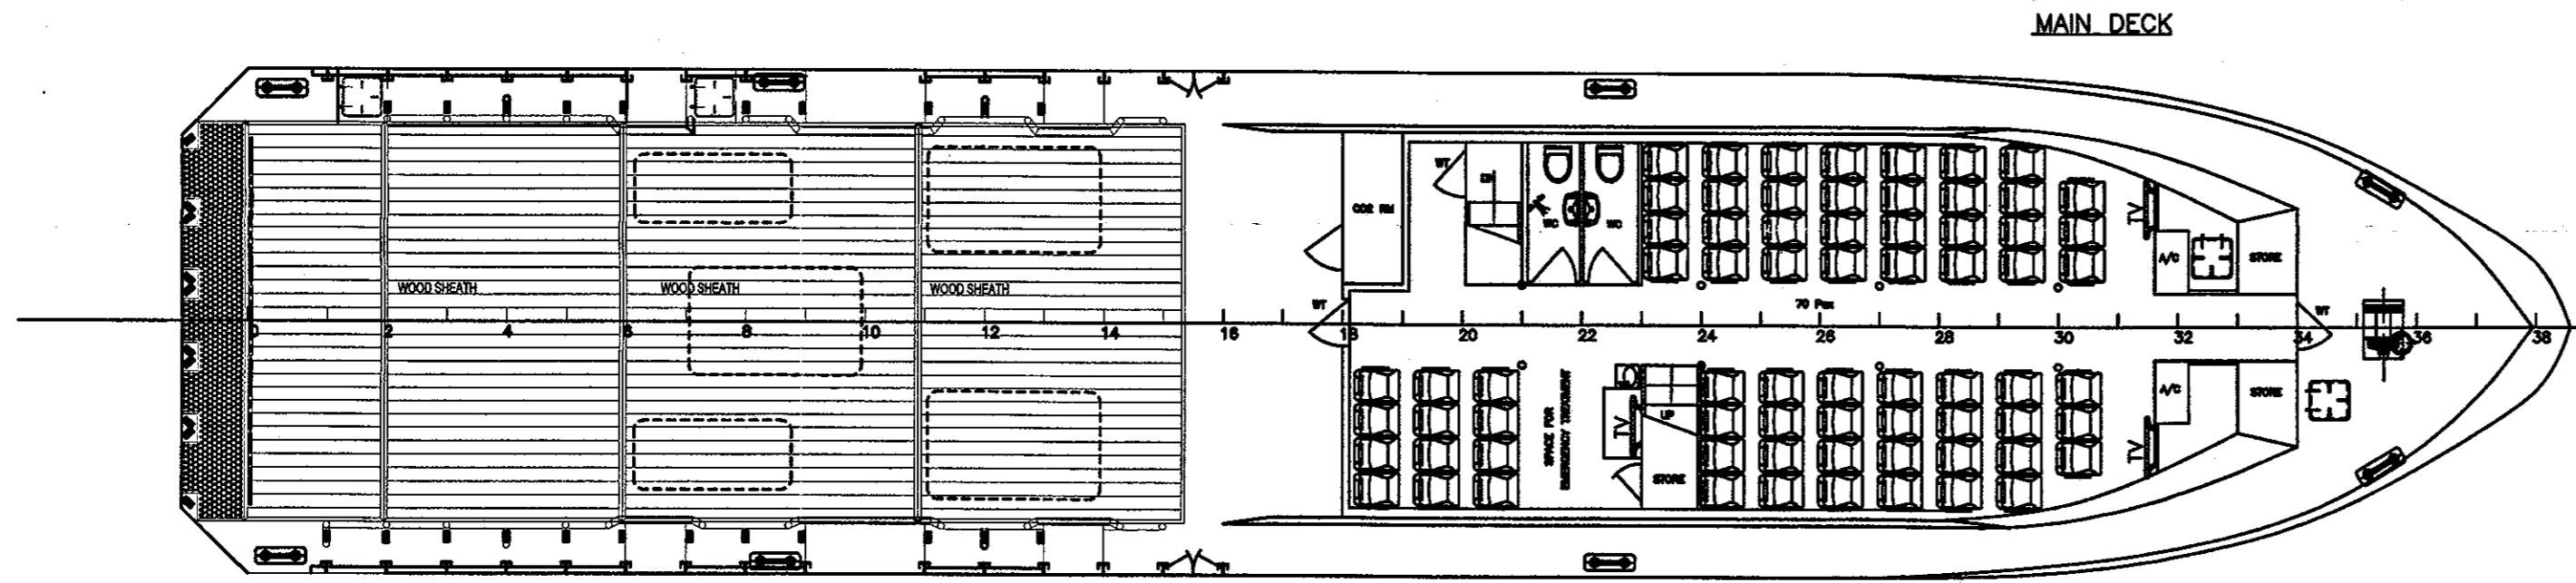
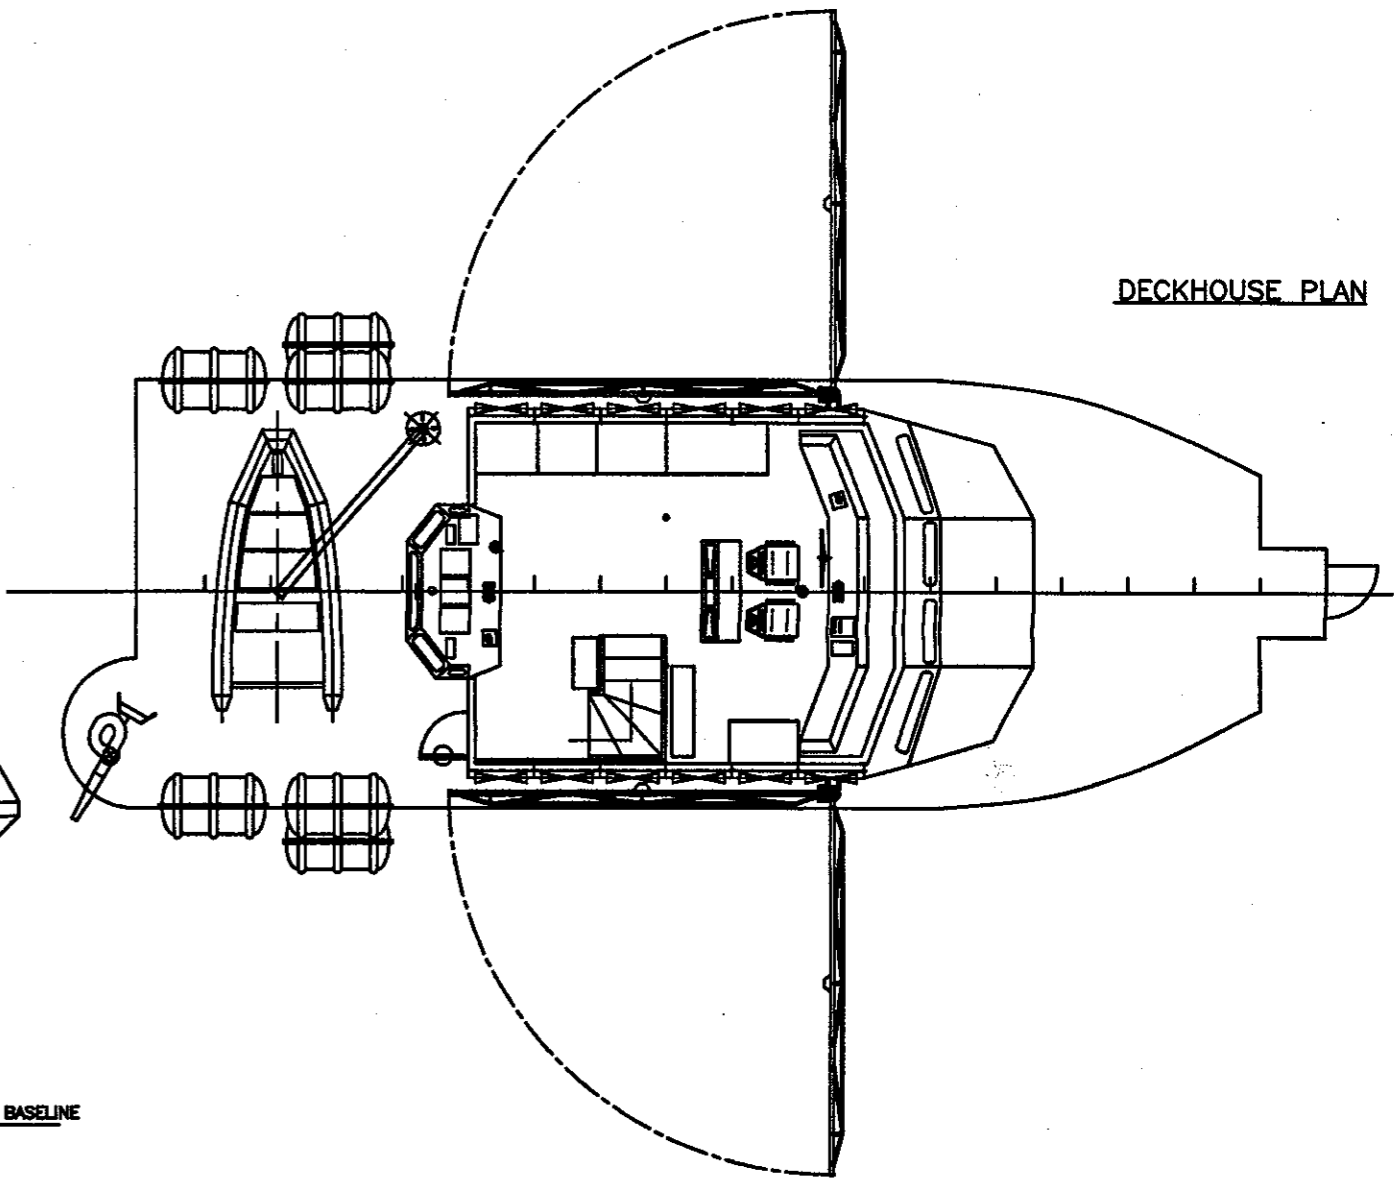


PRINCIPAL PARTICULARS

LENGTH O.A. ----- 36.00 M
 LENGTH B.P. ----- 33.20 M
 BREADTH MLD. ----- 7.60 M
 DEPTH MLD. ----- 3.65 M
 DESIGN DRAFT ----- 1.88 M
 COMPLEMENT ----- 8 CREW
 70 OFFSHORE WORKERS

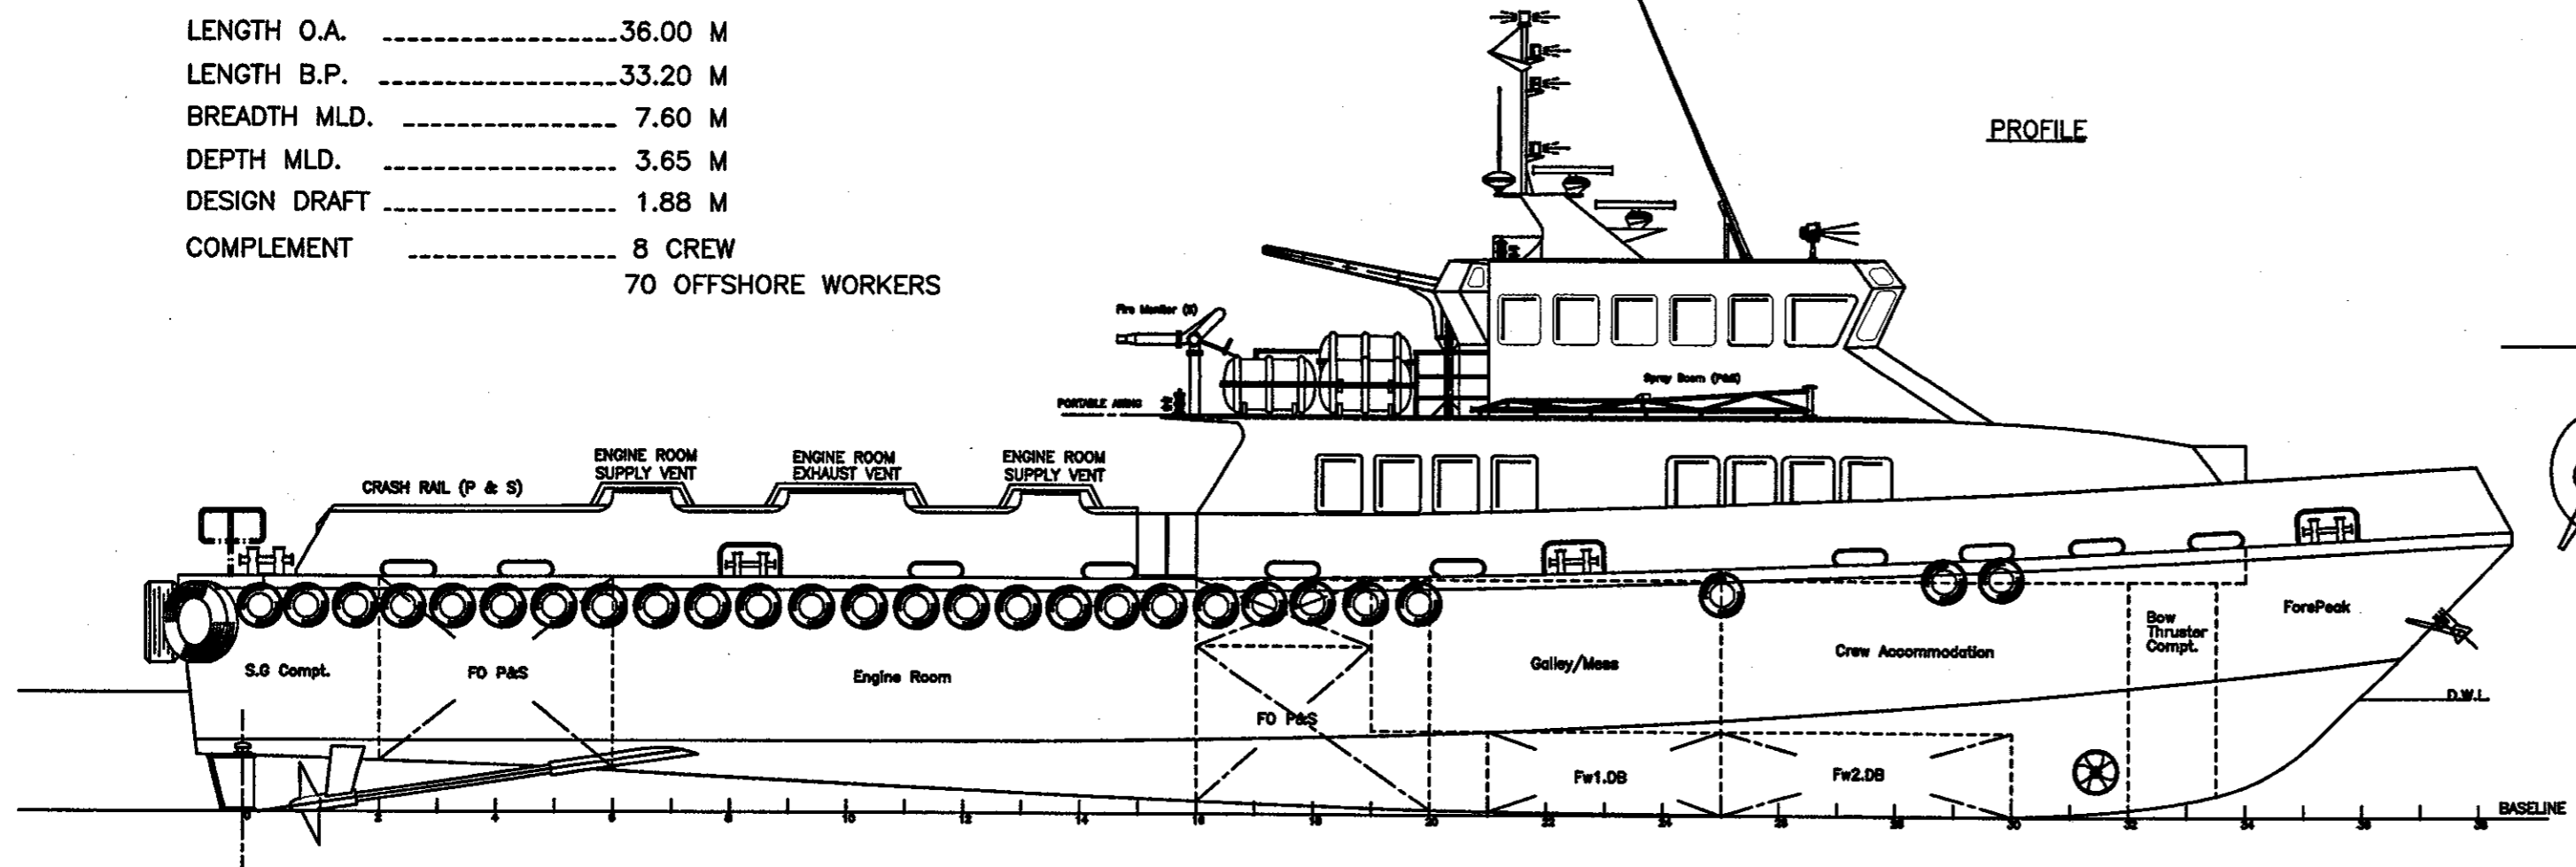

AS BUILT
Date: 31 JUL 2010

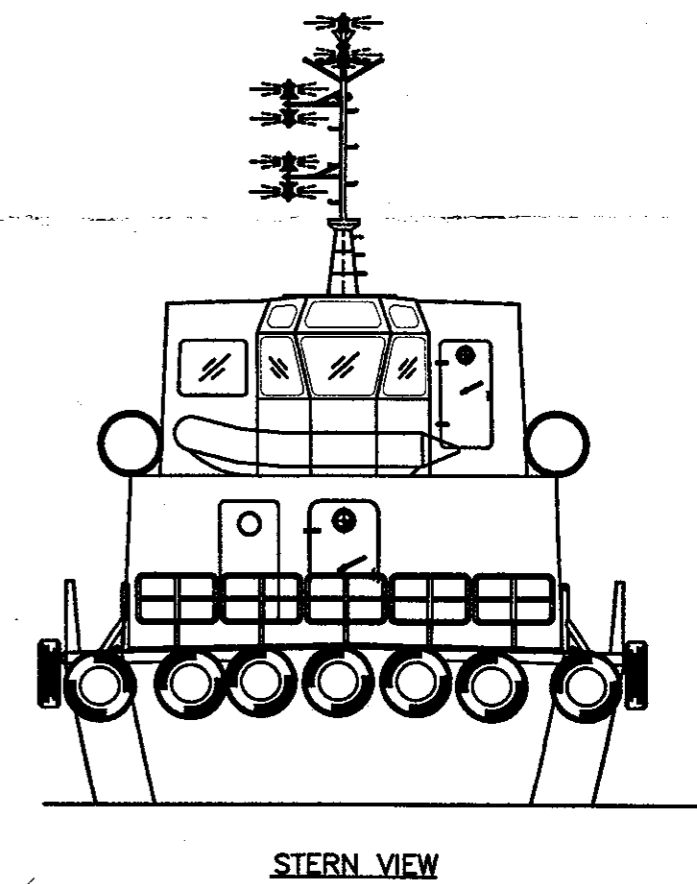

Rev No	Modification	Date	Done	Remark
B	indicate the second escape of crew accommodation	13,JAN,2009	ZH	ABS comment

PROJECT: 36M CREW BOAT (H165)
 TITLE: GENERAL ARRANGEMENT
PENGUIN SHIPYARD INTERNATIONAL PTE LTD
 Penguin 18 Tuas Basin Link, Singapore 638784 Tel: 68628322 Fax: 68622150
 DRAWN: ZH DATE: 13,AUG,2008 SCALE: 1:75
 CHECKED: BWB DATE: REVISION: B
 DRAWING No: PBIL-H162-G-01 SHEET: 1 OF 1