

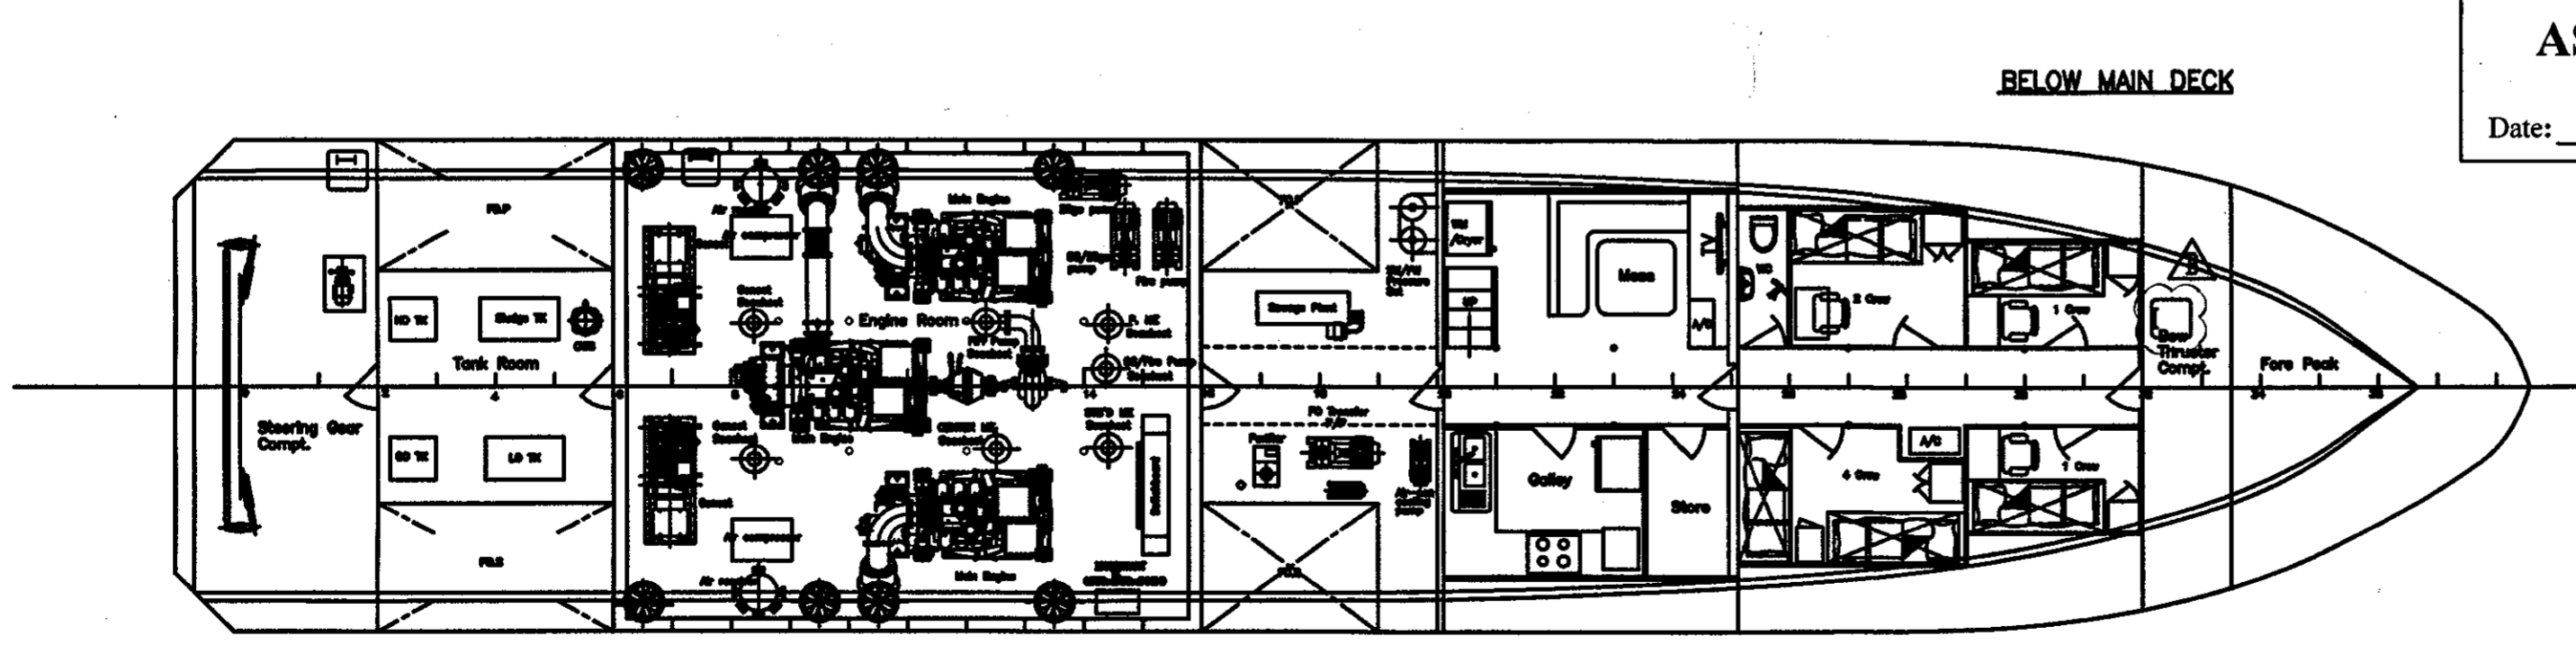
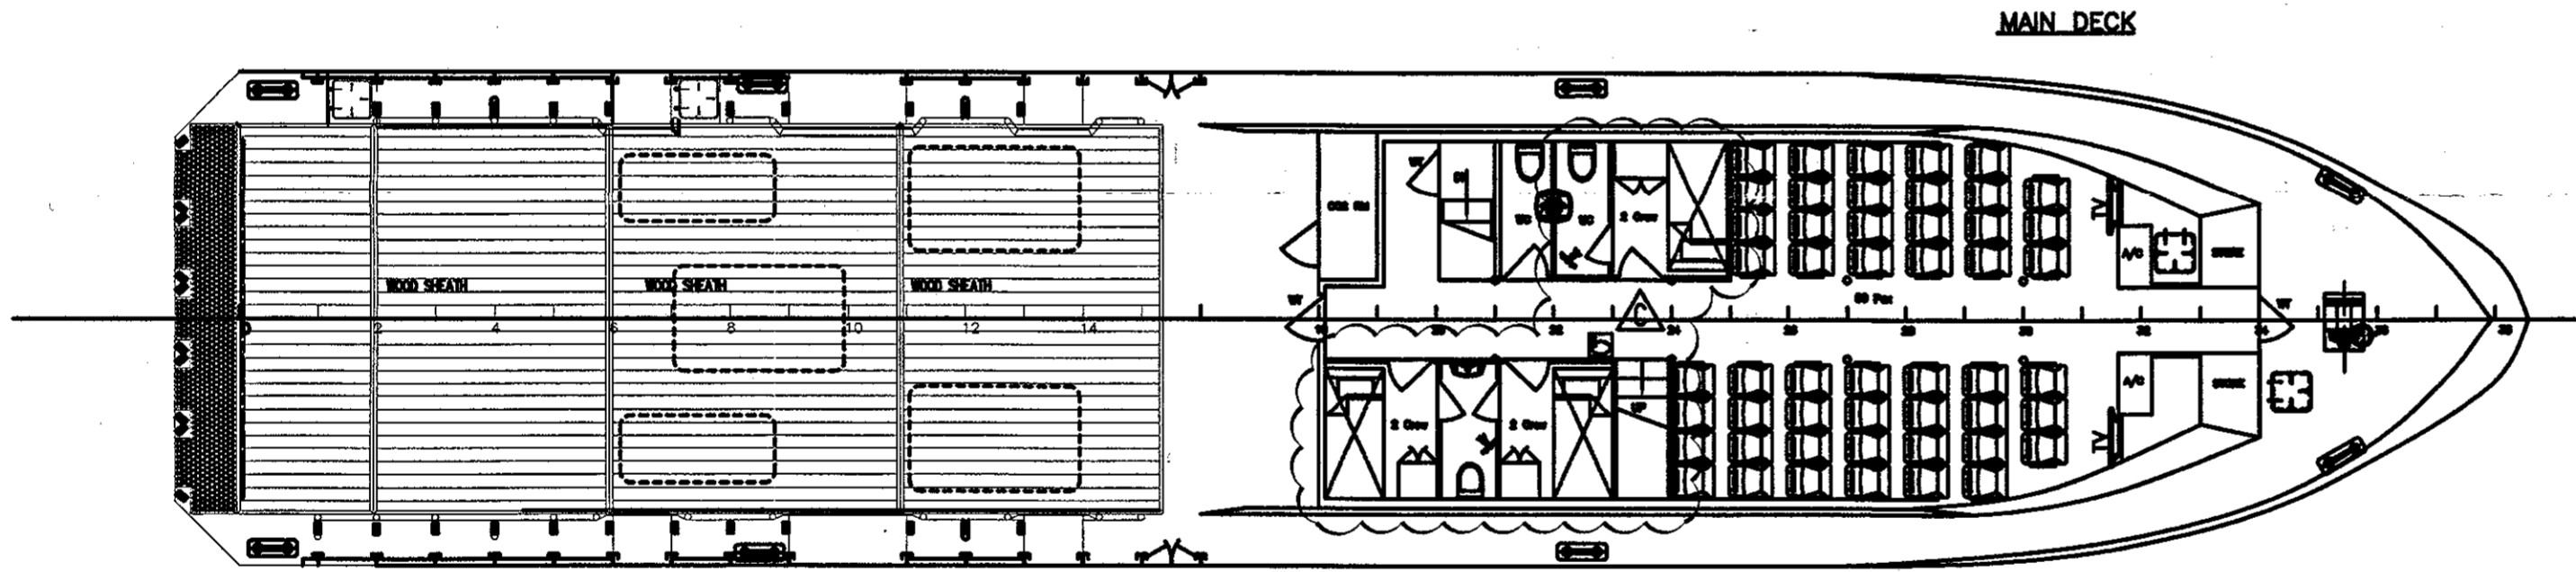
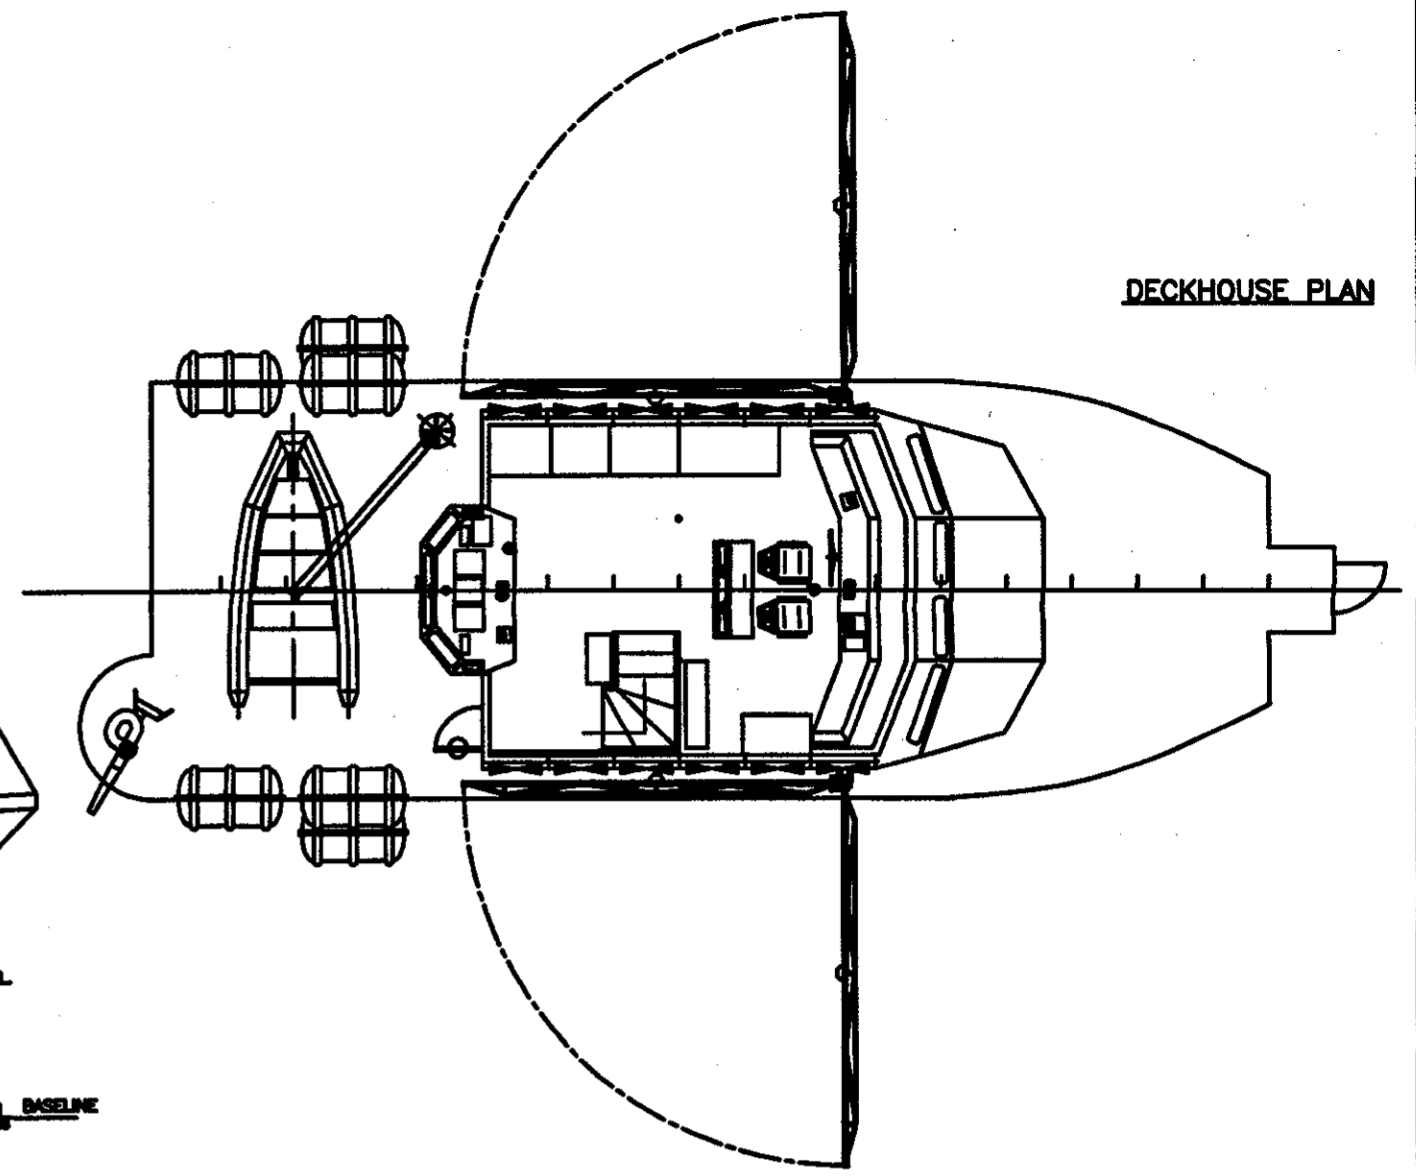


PRINCIPAL PARTICULARS

LENGTH O.A. ----- 36.00 M
 LENGTH B.P. ----- 33.20 M
 BREADTH MLD. ----- 7.60 M
 DEPTH MLD. ----- 3.65 M
 DESIGN DRAFT ----- 1.88 M
 COMPLEMENT ----- 14 CREW
 50 OFFSHORE WORKERS

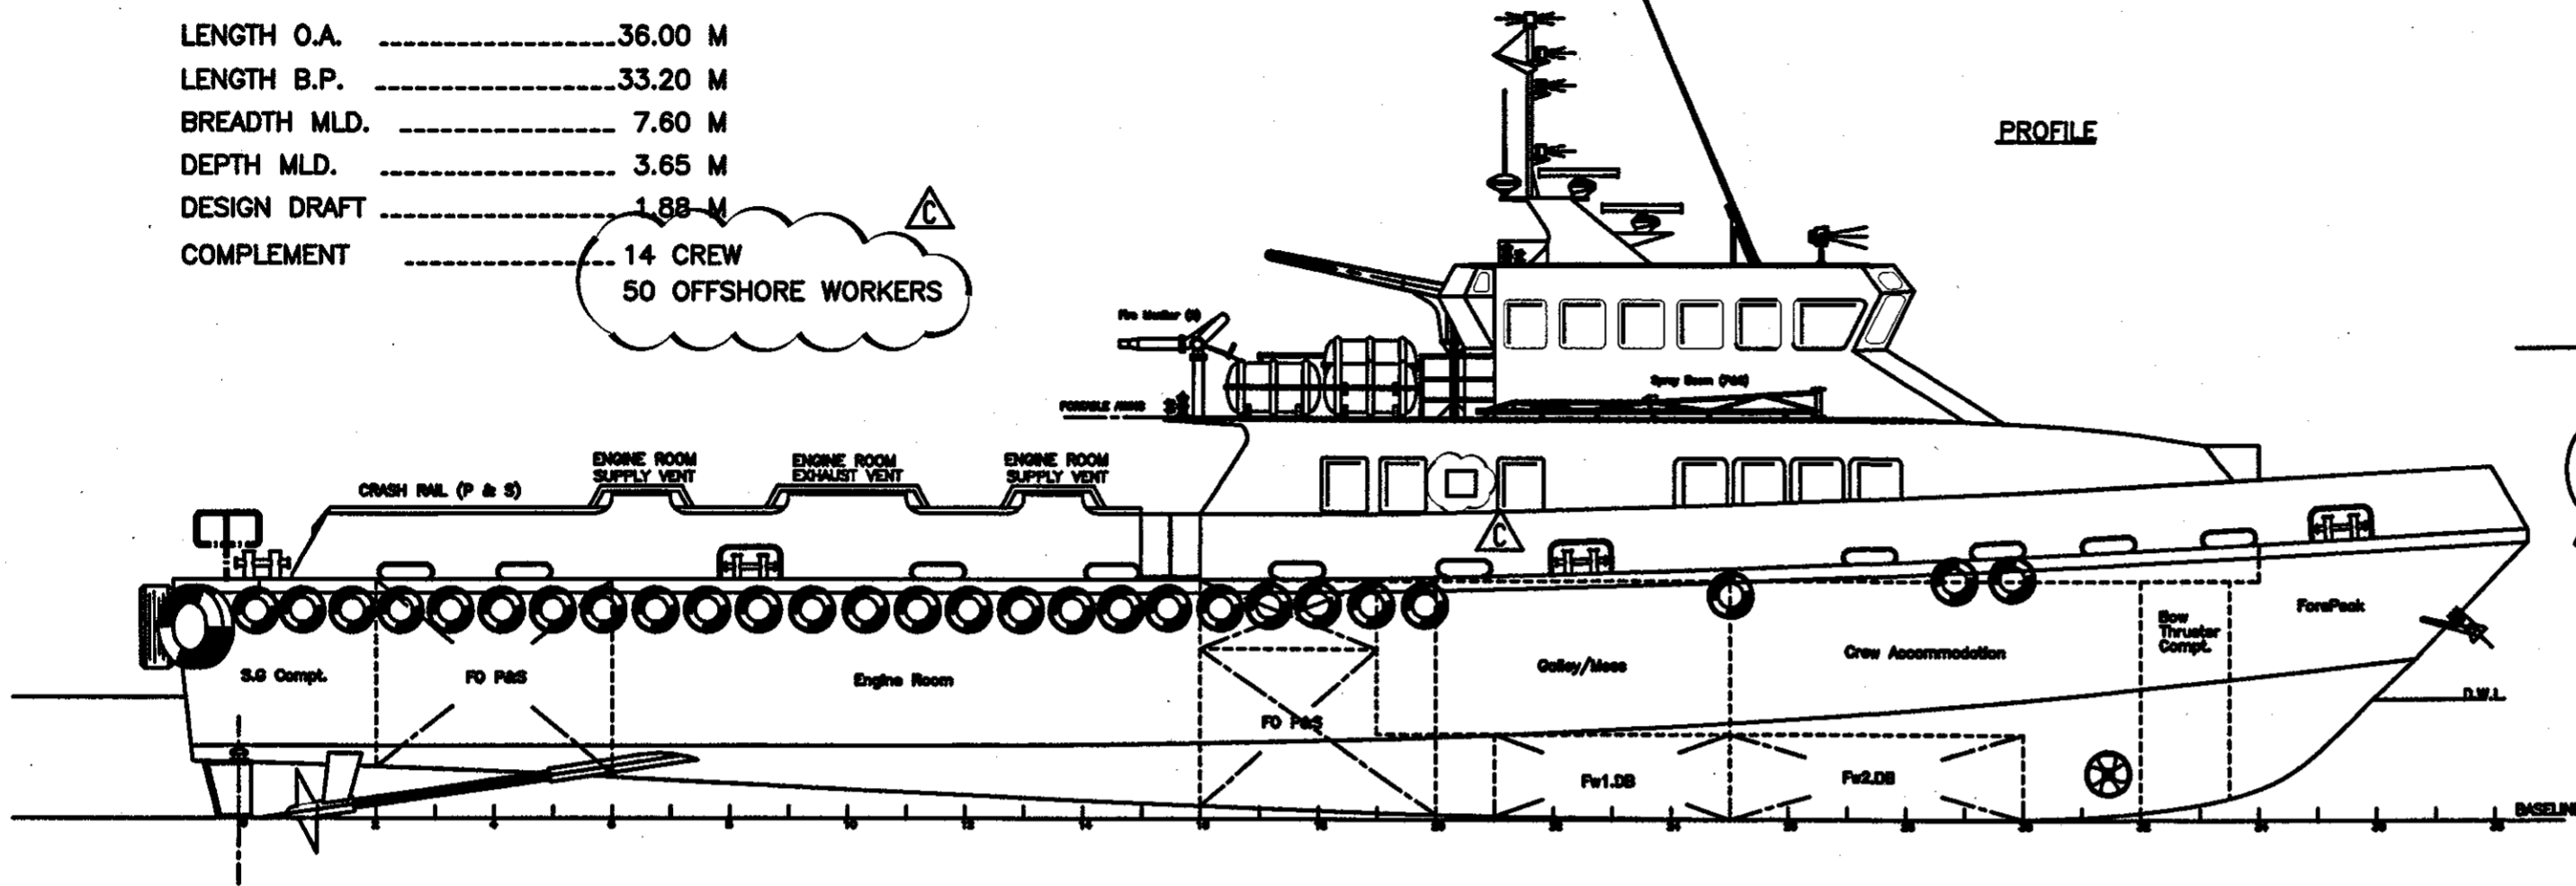

AS BUILT
 Date: 31 JUL 2010

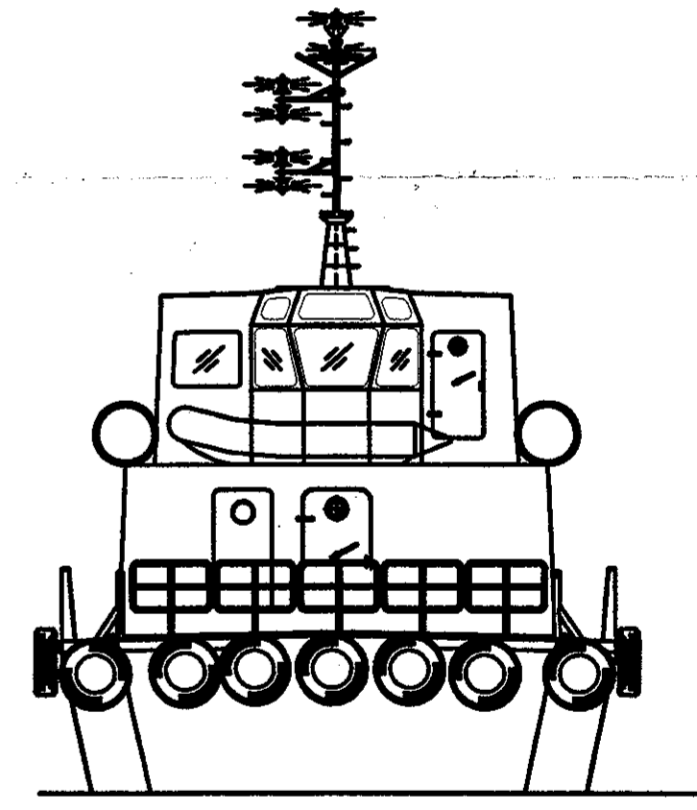

Rev No	Modification	Date	Done	Remark
C	Update Pax Saloon layout	09,JUN,2010	ZH	Owner Require
B	indicate the second escape of crew accommodation	13,JAN,2009	ZH	ABS comment
PROJECT: 36M CREW BOAT (H166)				
TITLE: GENERAL ARRANGEMENT				
PENGUIN SHIPYARD INTERNATIONAL PTE LTD 18 Tuas Bahk Link, Singapore 630784 Tel: 68628322 Fax: 68622150				
DRAWN: ZH	DATE: 13,AUG,2008	SCALE: 1/75		
CHECKED: BWB	DATE:	REVISION: C		
DRAWING No: PBIL-H162-G-01		SHEET: 1 OF 1		