
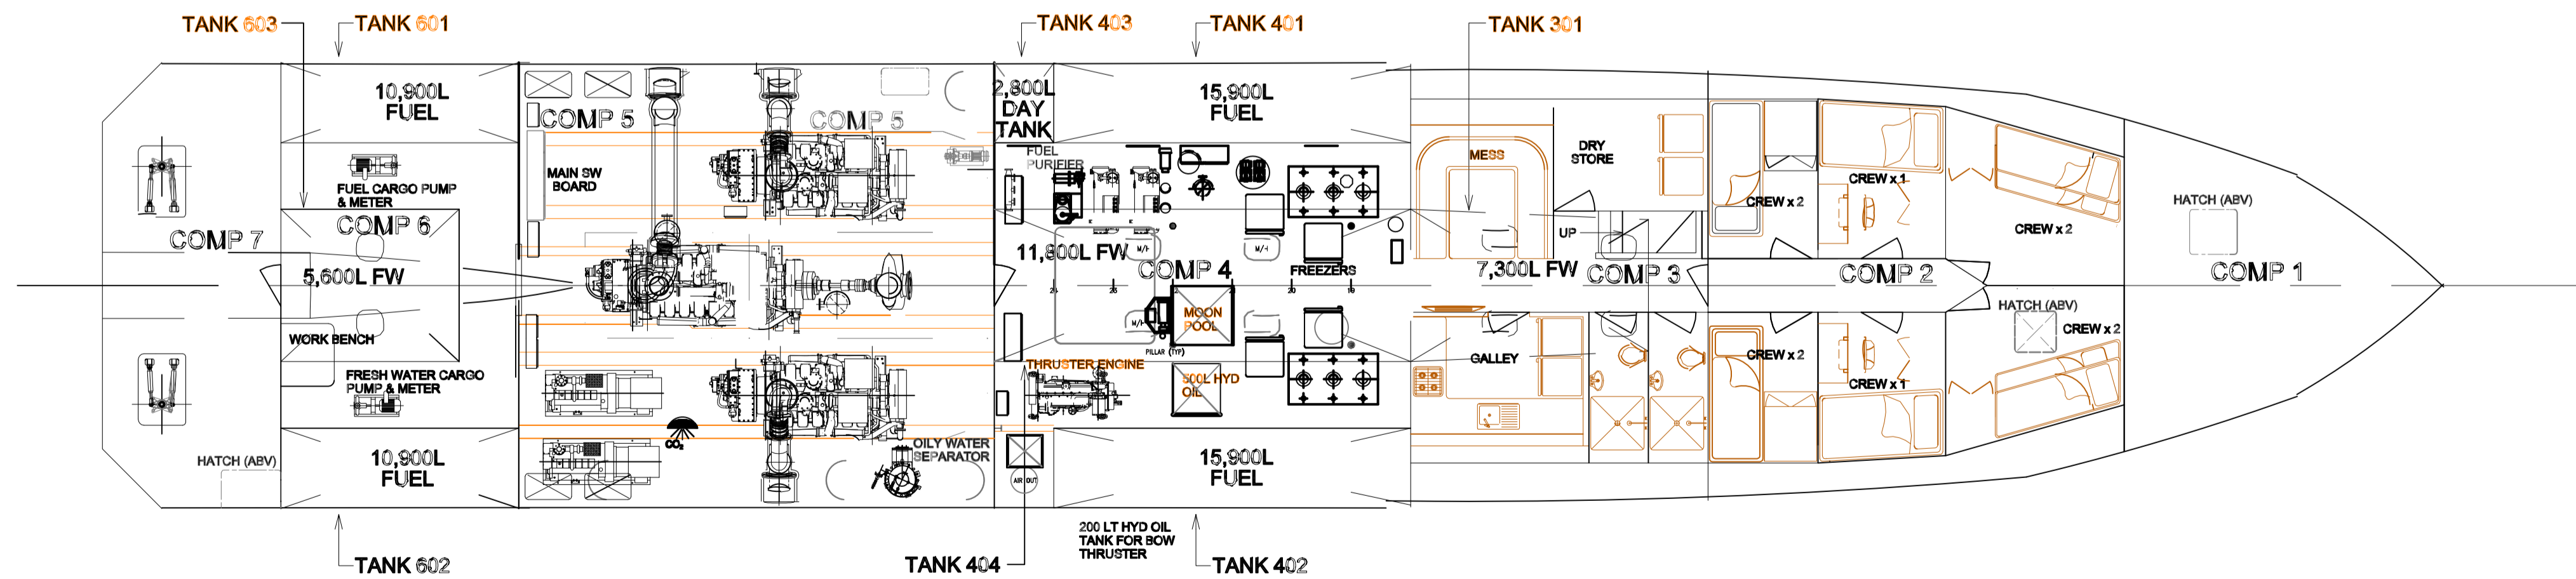
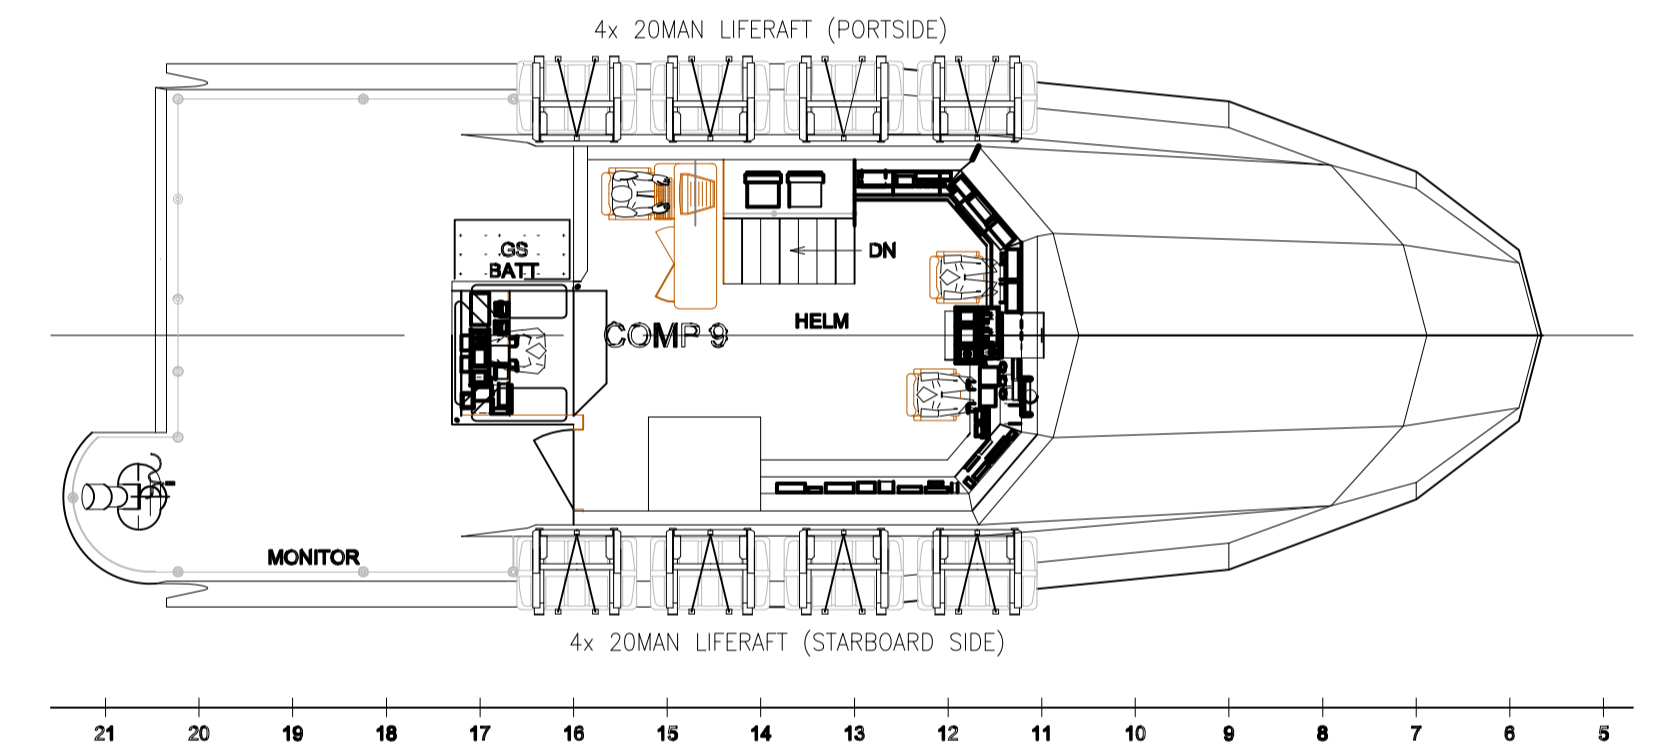



PRINCIPAL PARTICULARS	
LENGTH O.A.	40.37 M
LENGTH B.P.	35.00 M
BREADTH MLD.	7.50 M
DEPTH MLD.	3.22 M
DESIGN DRAFT	1.87 M
COMPLEMENT	10 P.O.B 66 PASSENGER

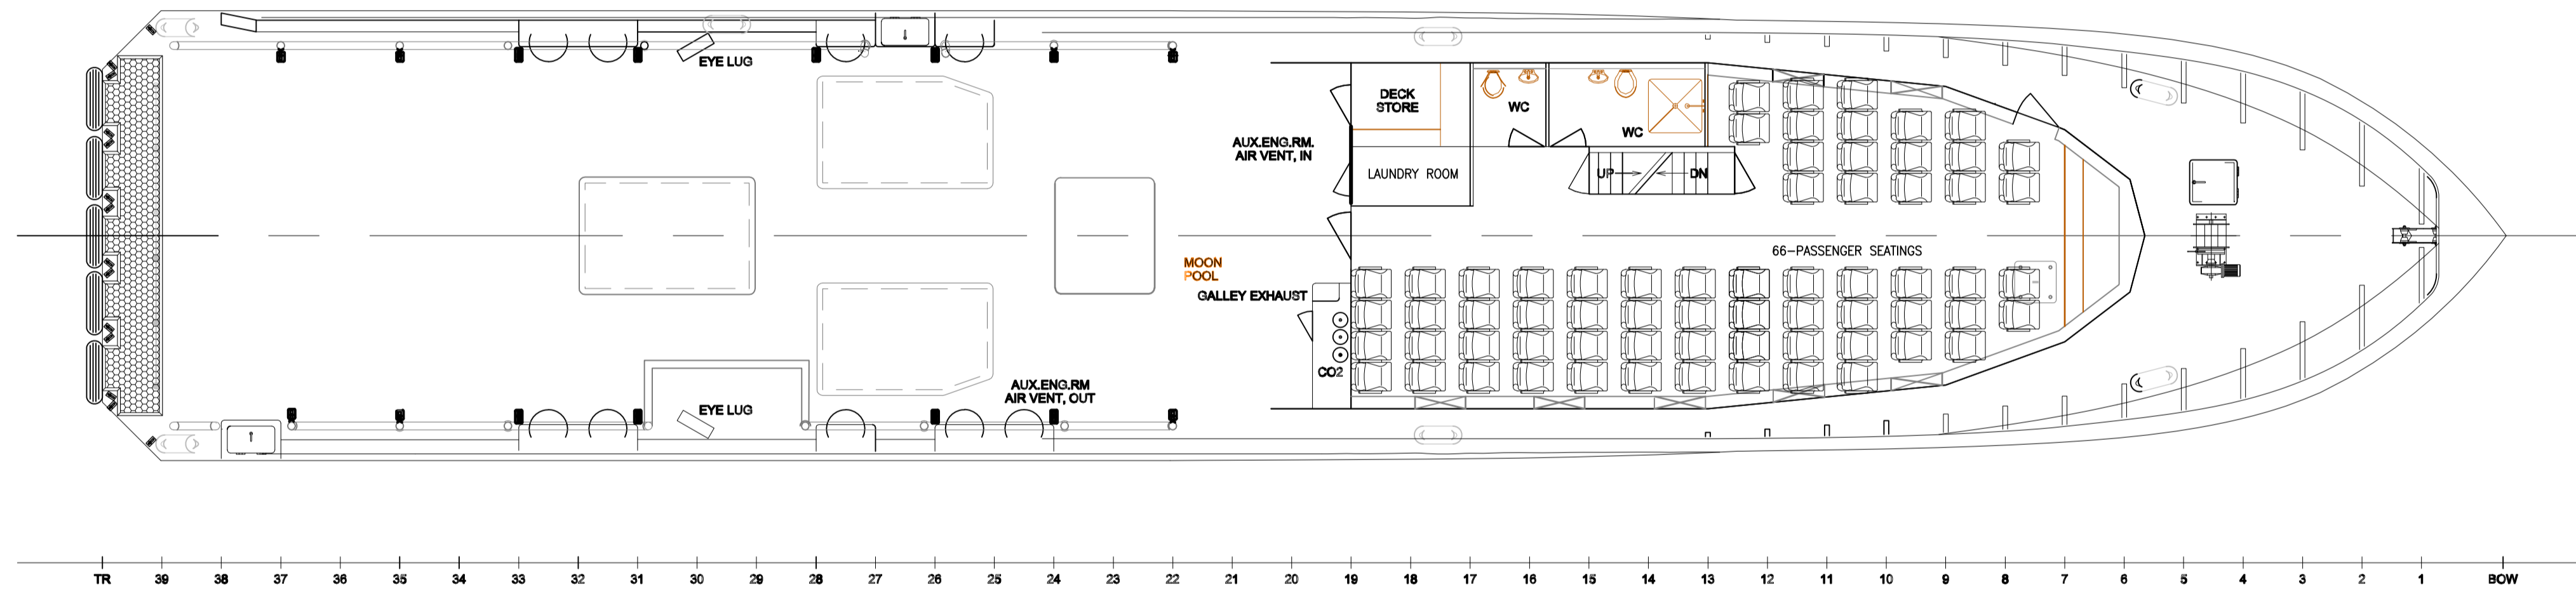

DESCRIPTION	REV	DRN BY	CHK BY	DATE
AS BUILT	B5	DCF	IJR	04.JAN.2016
UPDATE GENERAL ARRANGEMENT PLAN (OWNERS REQUEST)	B4	IJR	DCF	16.DEC.2015
UPDATE GENERAL ARRANGEMENT PLAN (OWNERS REQUEST)	B3	-	GM	13.NOV.2013

CLIENT: **MICLYN EXPRESS OFFSHORE**

	TITLE: <b>GENERAL ARRANGEMENT PLAN</b>	
	SHIP NAME: <b>SAMSON SUPPLIER</b>	
CONTRACT NO.:	DRAWING NO.:	SCALE:
	MEO-GAPSSUP-ENGG-0101	1:80
DRAWN: <b>IJR</b>	REV. NO.:	SHEET NO.:
	B5	1 OF 1
CHECKED: <b>DCF</b>	DATE:	SIZE:
	01 SEPT 2015	A1
APPROVED: <b>ERIK TING</b>		

This document contains Confidential Proprietary information and shall not be Copied, Reproduced, Used, Transferred to other Documents or Disclosed to others for any purpose unless Authorized by MEO.