




DECKHOUSE PLAN  
SCALE 1:75

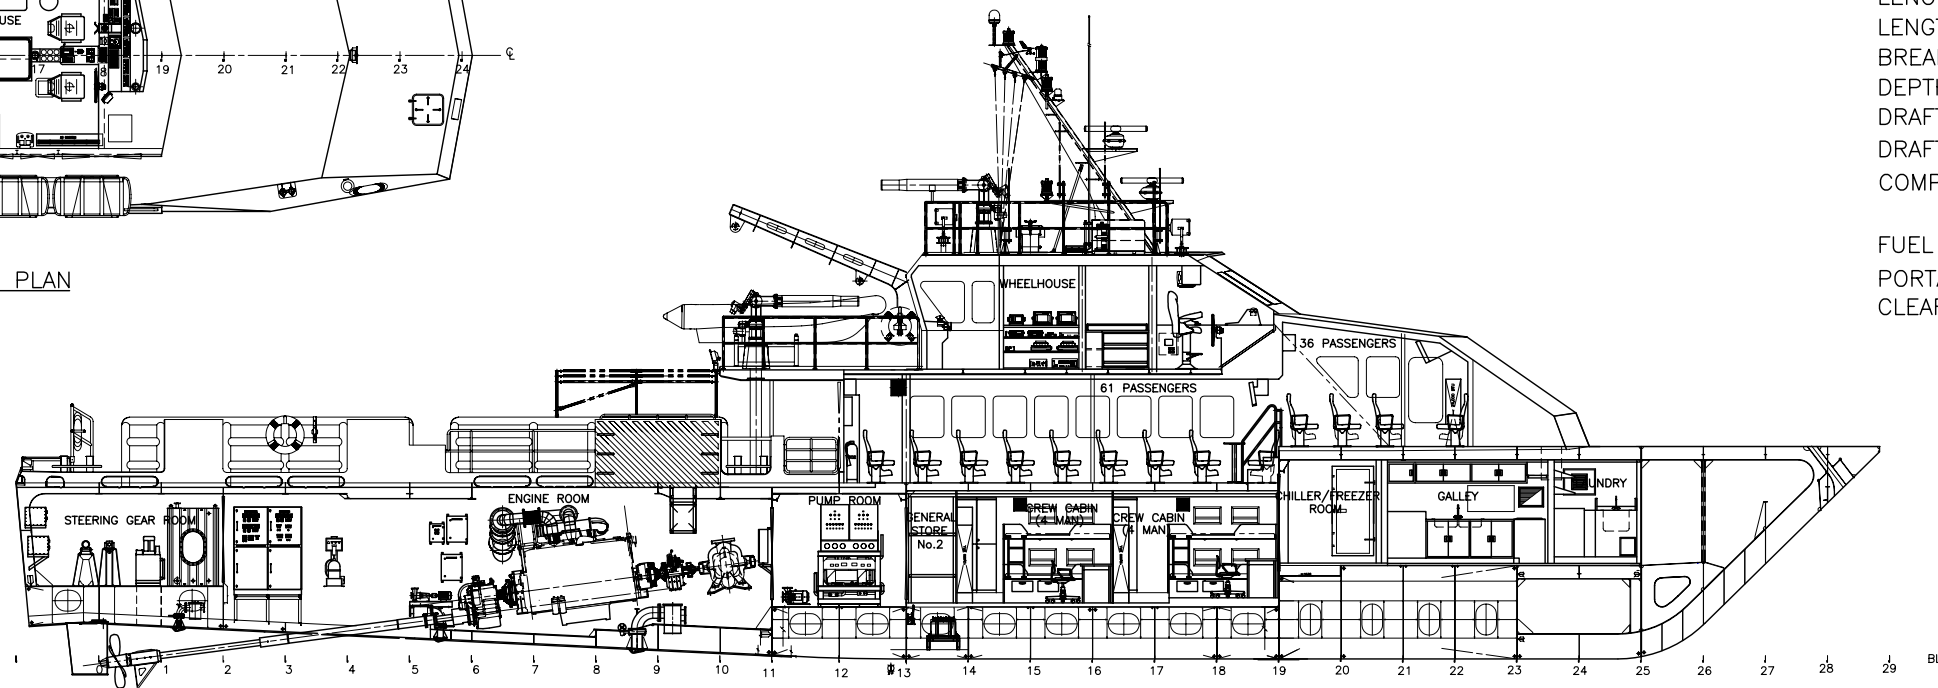

PROFILE  
SCALE 1:75

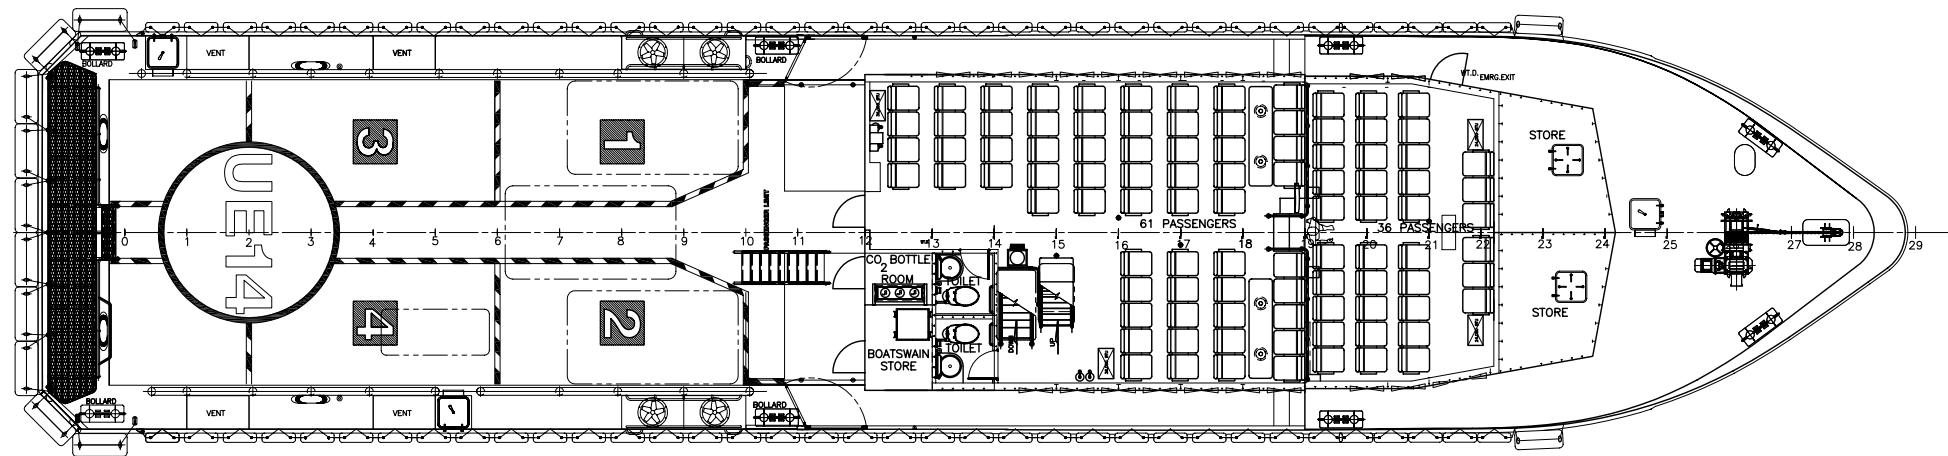

MAIN DECK  
SCALE 1:75

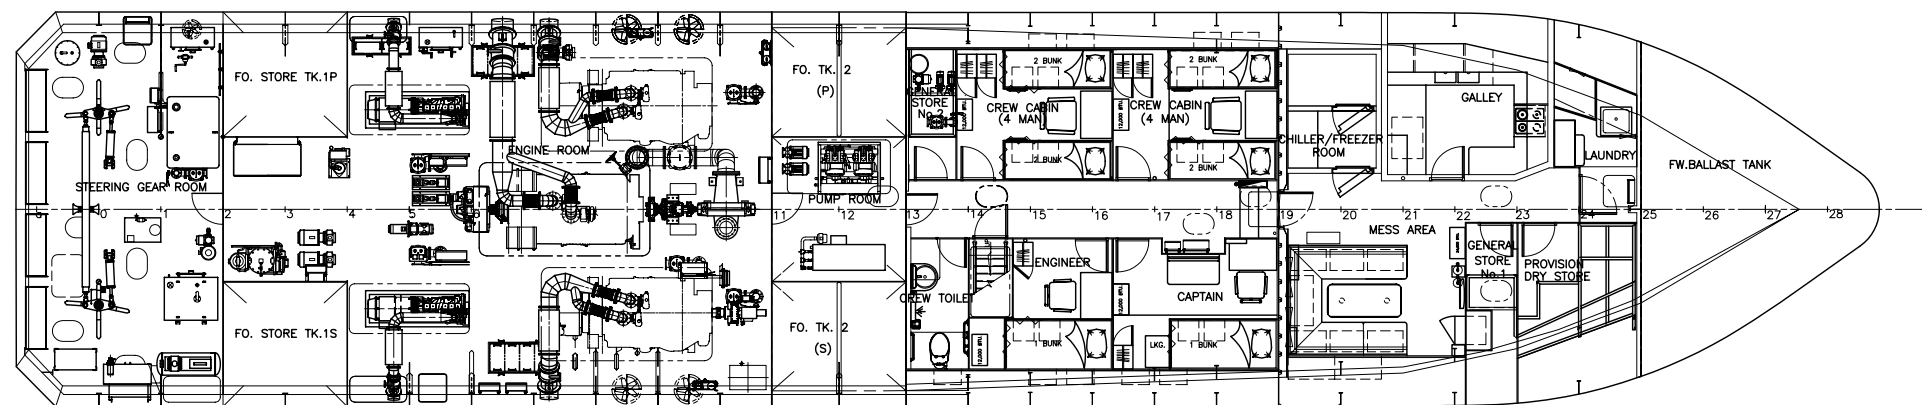

BELOW MAIN DECK  
SCALE 1:75

MAIN CHARACTERISTICS

LENGTH OVER ALL	36.00	M.
LENGTH WATERLINE	32.50	M.
BREADTH MOULDED	7.60	M.
DEPTH MOULDED	3.30	M.
DRAFT (DESIGN) MLD,(APPROX)	1.20	M.
DRAFT (LOADED) MLD,(APPROX)	1.70	M.
COMPLEMENT	8	CREW
	97	PASSENGERS
FUEL OIL	50	Cu.M
PORTABLE WATER	20	Cu.M
CLEAR DECK SPACE	87	Sq.M

AS-BUILT

NO.	ZONE	REVISION	BY	DATE
		OWNER	UNIWISE OFFSHORE LIMITED	
		OWNER	<b>MARSUN CO., LTD.</b> 413 Moo 4, Soi Sitthichai, Taliban Road, Muang, Samutprakorn, 10280, Thailand Tel.66(0)21738942-48 Fax.66(0)21738949 E-mail : contact@marsun.th.com Website : www.marsun.th.com	
HULL	BY	DATE		
GUIDANCE FOR CONSTRUCTION		SIGNATURE	DATE	PROJECT 36 m CREW/UTILITY VESSEL
APPROVED BY				PROJECT NO. 223
REVIEWED BY				TITLE GENERAL ARRANGEMENT (INBOARD)
CHECKED BY				
DRAWN BY	S.WEENA	19/2/52		
DESIGNED BY	W.SU	5/1/50		
CODE No. QS-E-7.3.0/223/01		DRAWING NO.	223-4-601-02	REV.
THIS DRAWING BELONGS TO MARSUN COMPANY LIMITED AND IS NOT TO BE COPIED OR USED FOR ANY PURPOSE WITHOUT OUR PERMISSION IN WRITING		ORIGINAL NO.	219-4-601-02	REV. -
		SCALE	1:75	SHEET 1 OF 1

FILE NAME: E:\223-4-601-02(223ASBUILT).DWG