


EOS 285

FLAT-TOP DECK CARGO BARGE


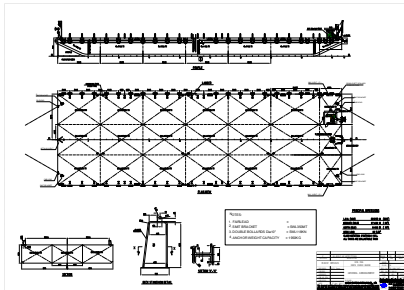


PRINCIPAL PARTICULARS

YEAR BUILT	2014
PORT OF REGISTRY	Indonesia
CLASS	Bureau Veritas
LENGTH OVERALL	85.34 m (280 ft)
BREADTH	27.43m (90 ft)
DEPTH MOULDED	5.48 m (18 ft)
DRAFT LOADED	4.30 m (14.1 ft)
DEADWEIGHT	7,889 T
GRT / NRT	3,396 T/ 1,624 T
DECK STRENGTH	20 T / m ²
TRANSVERSE BULKHEAD	Six (6)
LONGITUDINAL BULKHEAD	Two (2)

DECK EQUIPMENT


ANCHOR WINCH	1 x 10 t anchor windlass (Diesel Driven)
ANCHOR SMIT BRACKETS	1 x 1,920 kg stockless bower anchor 4 x smit towing brackets - P&S, fwd and aft
STANCHIONS	24 stanchions on each side
NAVIGATION LIGHTS	1 set solar type, P&S at fwd and aft
MOORING BOLLARDS	10 x mooring bollards of dia. 10" (recessed)
OTHER	1 x 5 t hand winch, 4 x closed Chock, 124 x

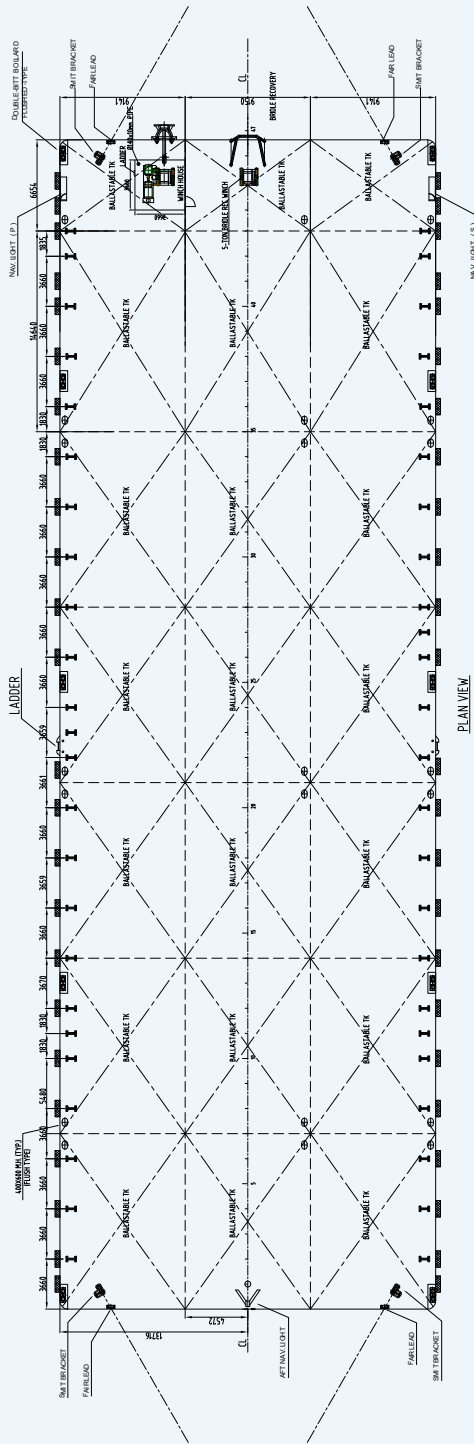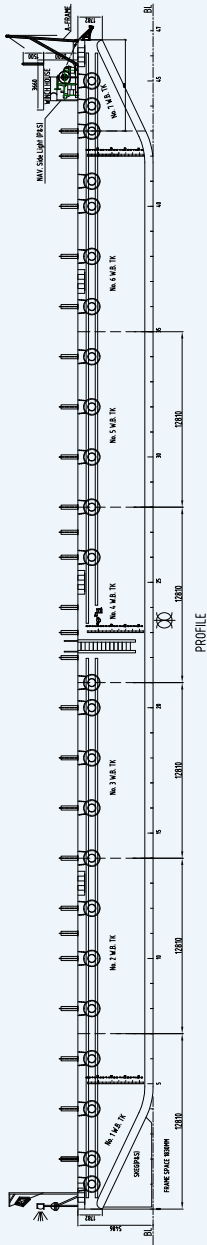

PRINCIPAL DIMENSIONS

LOA (MLD)	65.344 M (214' 7")
BREADTH (MLD)	27.432 M (90')
DEPTH (MLD)	5.488 M (18')
DECK LOAD	20 T/M ²
CLASS NOTATION: PONDONON I HULL	
ALL TANKS ARE BALLASTABLE TANK	

- NOTES:**
1. FAIRLEAD = SWL350MT
 2. SMIT BRACKET = SWL118KN
 3. DOUBLE BOLLARDS Dia10" = SWL118KN
 4. ANCHOR WEIGHT CAPACITY = 1950KG

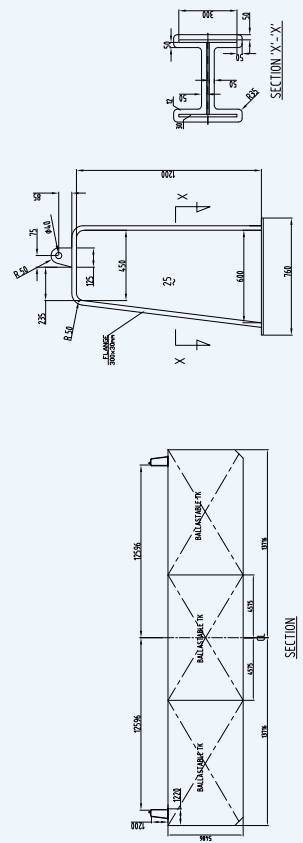

C	AS-BUILT OF OPERATIONS	MARK	FR	DATE
REVISION	DESCRIPTION	BY	DATE	
BASIC DESIGN	DECK 2885			
DESIGNED	DECK CARGO RANGE	OWNER		
CHECKED	U.E. TITLE	CLASS. BY		
APPROVED	GENERAL ARRANGEMENT	DRG. NO.		
DATE		SCALE		
DATE		SCALE		
DATE		SCALE		

The drawing on the information contained in the vessel's Certificate of Approval, Class Notation, and other documents is the property of the company. It is not to be used for any other purpose without the written consent of the company.

MEOS
MEOS OFFSHORE SOLUTIONS
137, 138, 139, 999, 1000.

Vessel particulars are believed to be correct but are not guaranteed. Owners reserve the rights to amend the specifications without notification. Particulars are entirely without warranty as to correctness. Interested parties must inspect vessel's certificates, drawings or conduct a physical inspection of vessel.