PRINCIPAL PARTICULARS:

LENGTH O.A.	70.25m
LENGTH W.L.	67.70m
BEAM MLD.	16.00m
DEPTH MLD.	6.00m
DRAFT DESIGNED / max.	4.50m / 5.10m
COMPLEMENT	55 MEN

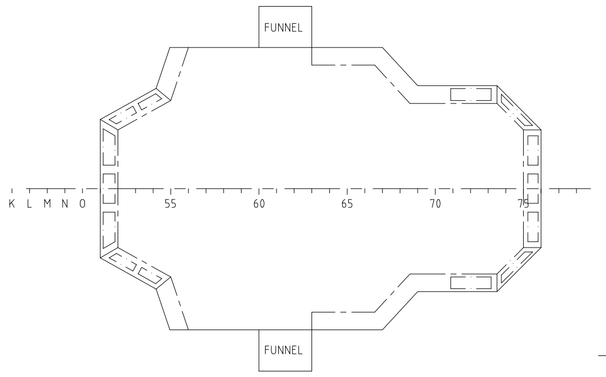

WHEELHOUSE TOP

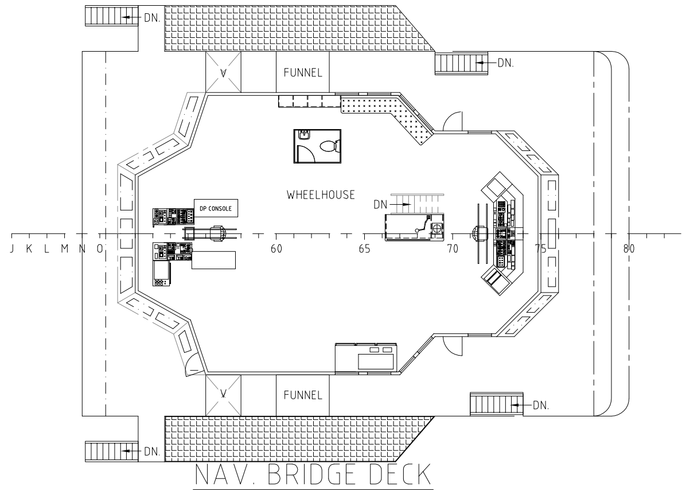

NAV. BRIDGE DECK

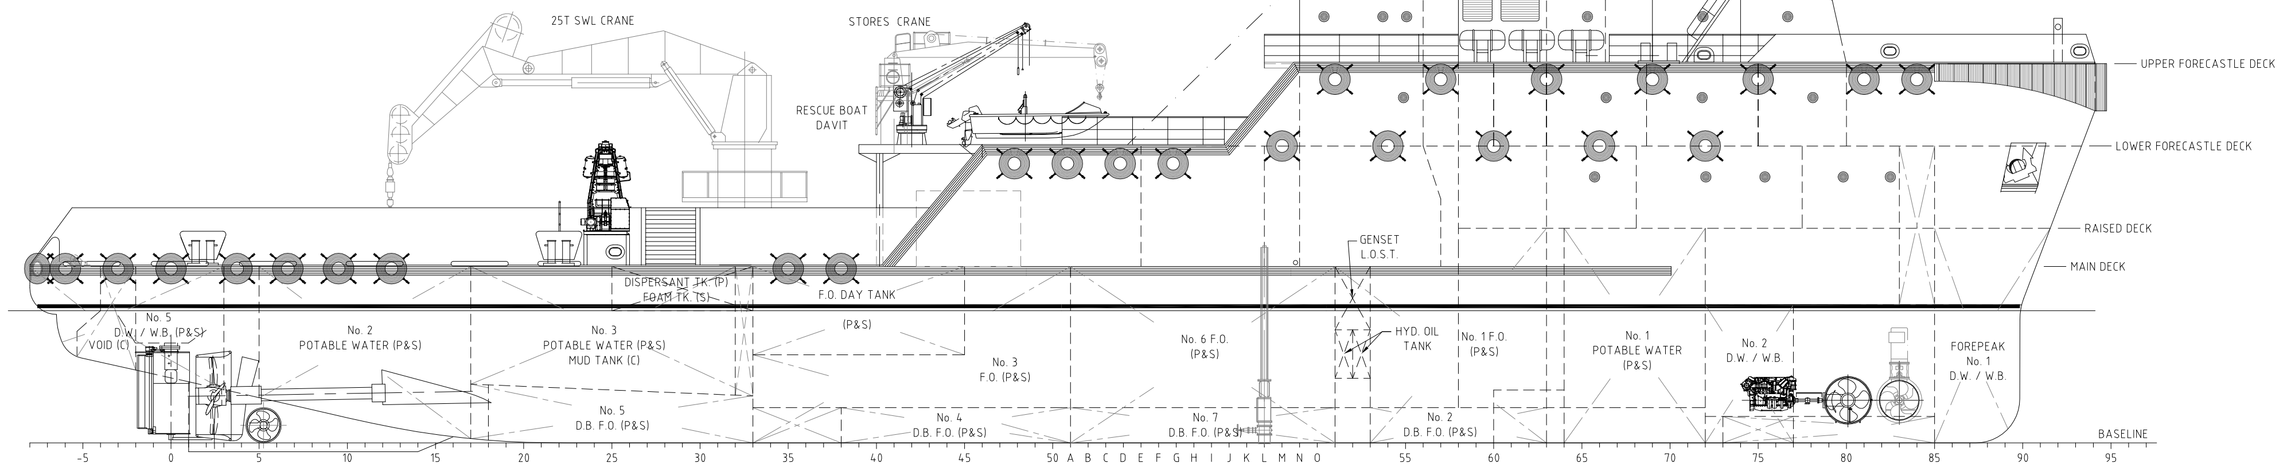

OUTBOARD PROFILE

FRAME SPACING 600mm THROUGHOUT

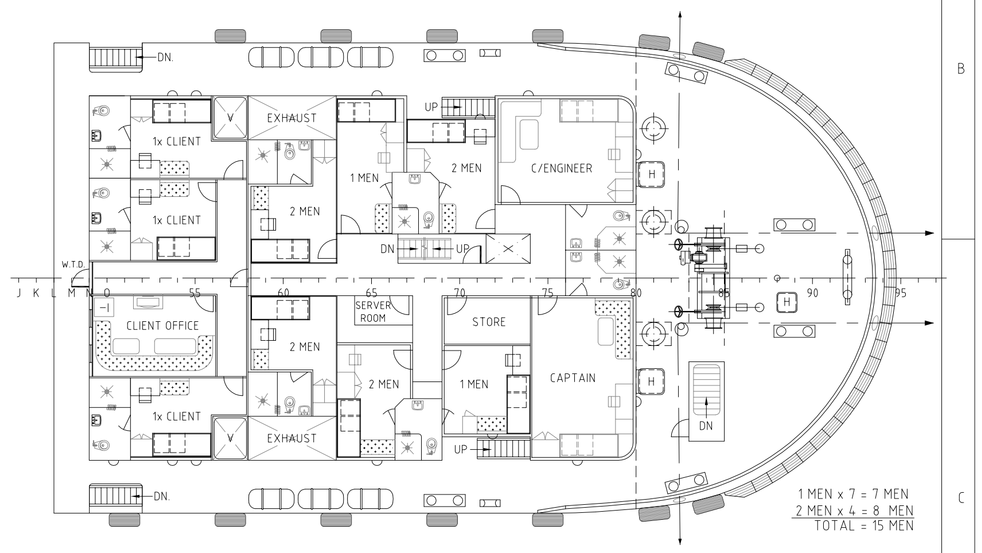

UPPER FORECASTLE DECK

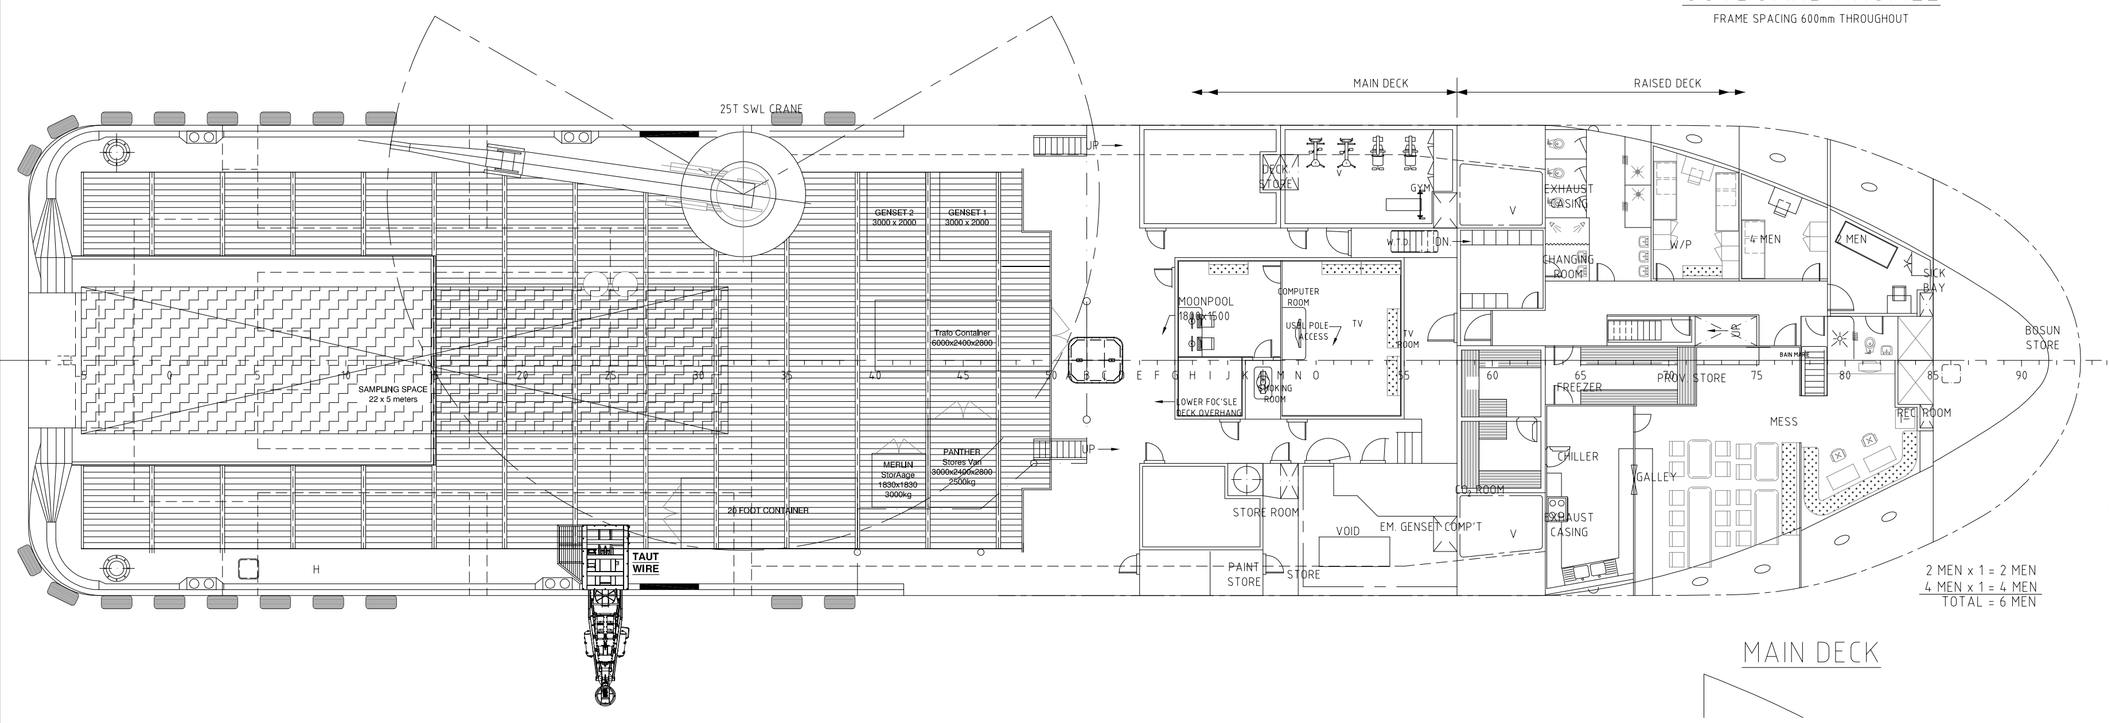

MAIN DECK

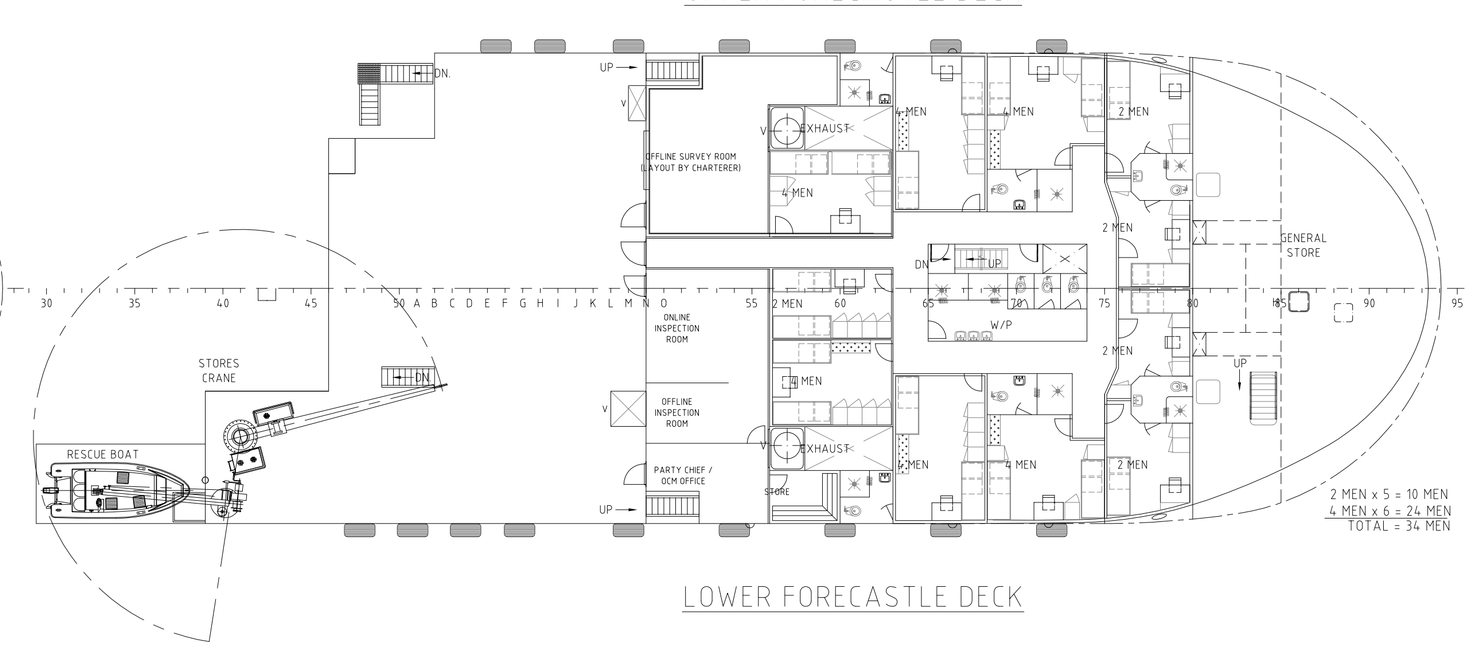

LOWER FORECASTLE DECK

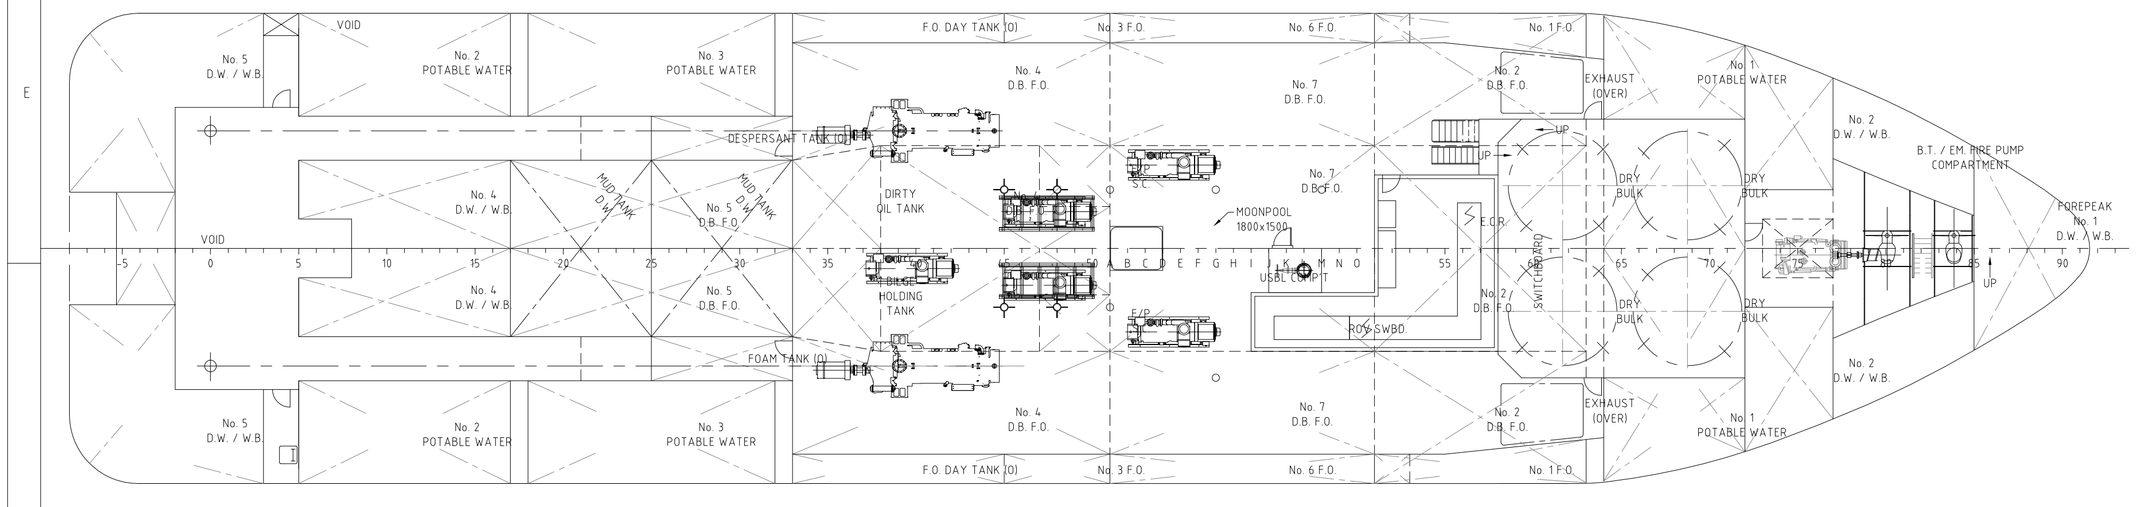

BELOW MAIN DECK

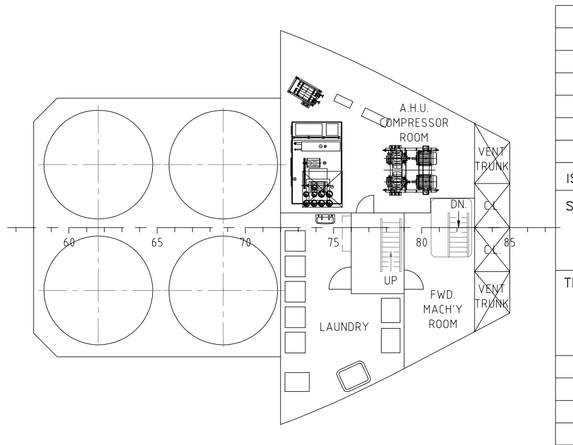

ACCOMMODATION TWEEN DECK

ISSUE	DATE	BY	REVISION	CLIENT APPROVAL
6	11/5/16	DCF	MERLIN AND PANTHER ROV LOCATION PROPOSAL	
5	18/02/13	IJR/DCF	ISSUED FOR INFORMATION (OWNER)	
4	24/01/13	IJR/DCF	ISSUED FOR INFORMATION (OWNER)	
3	28/01/09	S.W.	ISSUED FOR INFORMATION - (OWNER)	
2	13/11/08	S.W.	ISSUED FOR INFORMATION - (OWNER/ABS)	
1	07/11/08	S.W.	ISSUED FOR INFORMATION - (OWNER/ABS)	
0	08/10/08	S.W.	ISSUED FOR CONSTRUCTION - (ABS APPROVED)	

SHIP: 70.25m DP2 ROV SUPPORT VESSEL
(MICLYN ENDEAVOR)

TITLE: GENERAL ARRANGEMENT - AS BUILT

OWNER	OFFSHORE CHARTERS PTE LTD
BUILDER	PT MICLYN SHIPBUILDING & ENGINEERING — YARD NO.
CLASS	ABS ✠ A1Ⓔ OFFSHORE SUPPORT VESSEL ✠ AMS ✠ DP2 MULTI-PURPOSE VESSEL

INTERNATIONAL MARITIME CONSULTANTS PTY. LTD.
Naval Architects | Marine Engineers | Project Managers
SUITE 2, LEVEL 1 QUEENSGATE CENTRE, WILLIAM STREET, FREMANTLE, WESTERN AUSTRALIA 6160.
TEL: 08 9335 1991, FAX: 08 9335 1995,
E-MAIL: imc@international-maritime.com.au WEB: www.international-maritime.com.au

DRAWN	CHECKED	APPROVED	SCALE	DRAWING NO.	REV
T.M.	P.B.	R.J.W.	1:150	07-657-001	5
23/11/07	28/01/09	28/01/09	A1		

This drawing and all information shown hereon are the exclusive property of INTERNATIONAL MARITIME CONSULTANTS PTY. LTD. A.C.N. 065 754 341 and is submitted only on a confidential basis. The recipient agrees not to reproduce the drawing, to return it upon request, and that no disclosure of the drawings or the information shown hereon will be made to a third party without the prior written consent from I.M.C.

This drawing has been produced under the controls established by BVQI APPROVED QUALITY MANAGEMENT SYSTEM that conforms with ISO 9001:2000. BVQI Certificate Number: 129748.