PRINCIPAL PARTICULARS

LENGTH O.A.	36.00 M
LENGTH B.P.	33.20 M
BREADTH MLD.	7.60 M
DEPTH MLD.	3.65 M
DESIGN DRAFT	1.88 M
COMPLEMENT	8 CREWS
	70 OFFSHORE WORKERS

PROFILE

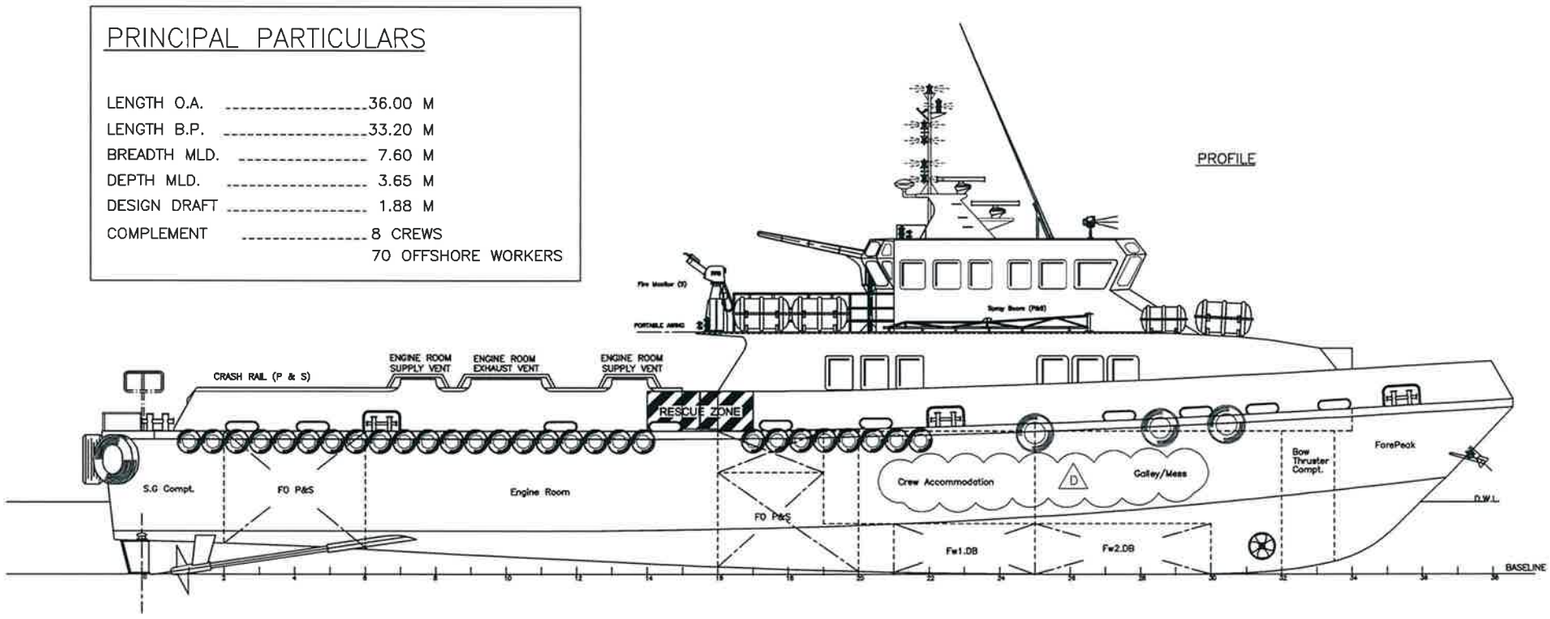

WHEELHOUSE TOP

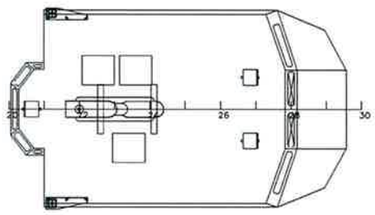

WHEELHOUSE PLAN

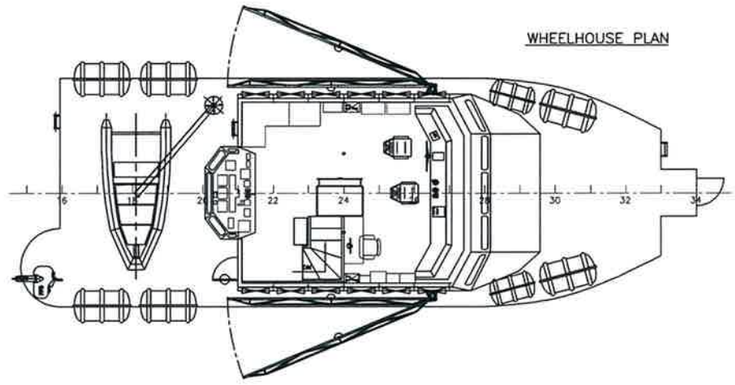

MAIN DECK

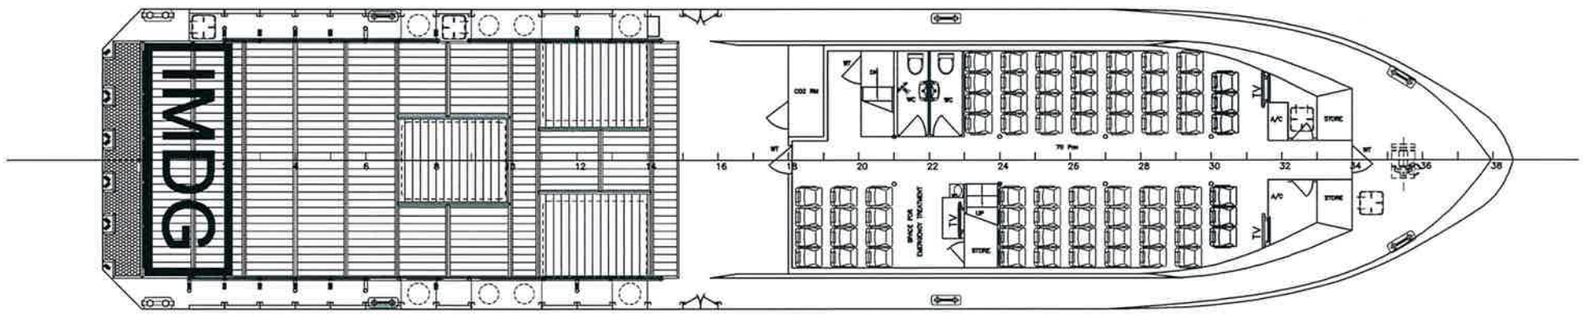

BELOW MAIN DECK

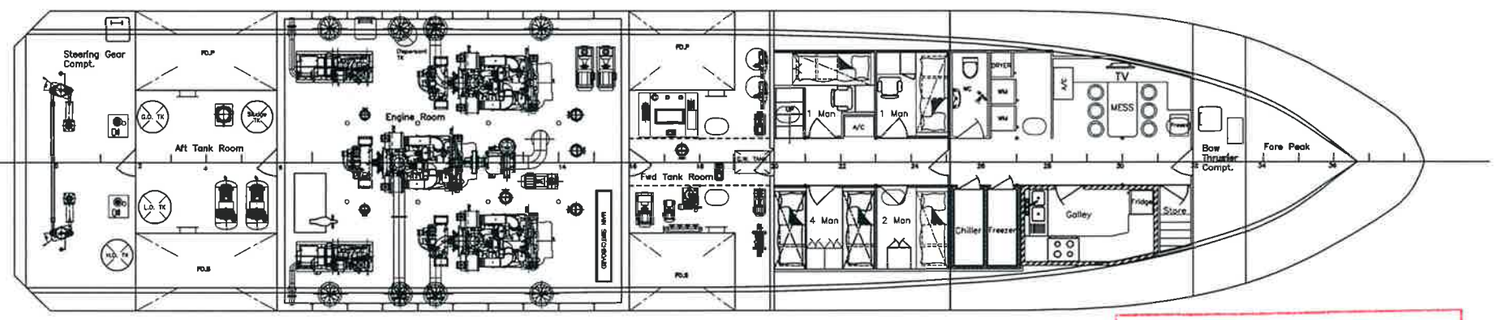

AS BUILT

Date: 01 APR 2012

STERN VIEW

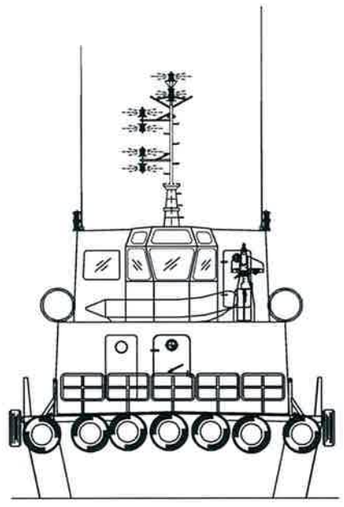

FRONT VIEW

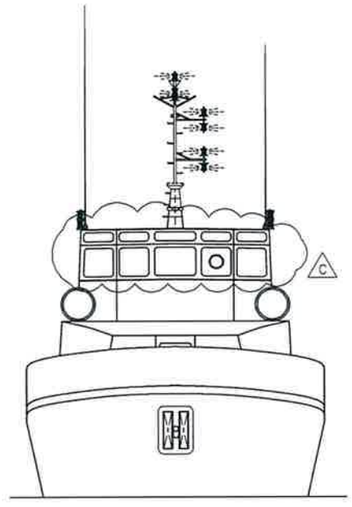

Rev	Modification	Date	Done	Remark
D	Revised compt. name in profile view	29,NOV,2011	ZH	Yard Comment
C	Update W/H windows	03,MAY,2011	ZH	Yard Comment
B	Rearrange Galley/Mess Room & Crew Accommodation	20,APR,2011	ZH	Owner Request

PROJECT: Flex-36 (H182)

TITLE: GENERAL ARRANGEMENT

PENGUIN SHIPYARD INTERNATIONAL PTE LTD

18 Tuas Basin Link, Singapore 638784 Tel: 68626322 Fax: 68622150

This drawing and the information contained herein is supplied on the understanding that they are the exclusive property of Penguin Shipyard International Pte Ltd. They must not be used or reproduced in whole or in part, without permission in writing.

DRAWN: ZH	DATE: 04,MAR,2010	SCALE: 1:75 (A1)	
CHECKED: PATRICK	DATE: 04,MAR,2010	REVISION: D	
DRAWING No.: PBIL-H168-G-01		SHEET: 1 OF 1	