PRINCIPAL PARTICULARS

LENGTH O.A.	36.00 M
LENGTH B.P.	33.20 M
BREADTH MLD.	7.60 M
DEPTH MLD.	3.65 M
DESIGN DRAFT	1.88 M
COMPLEMENT	8 CREWS
	70 OFFSHORE WORKERS

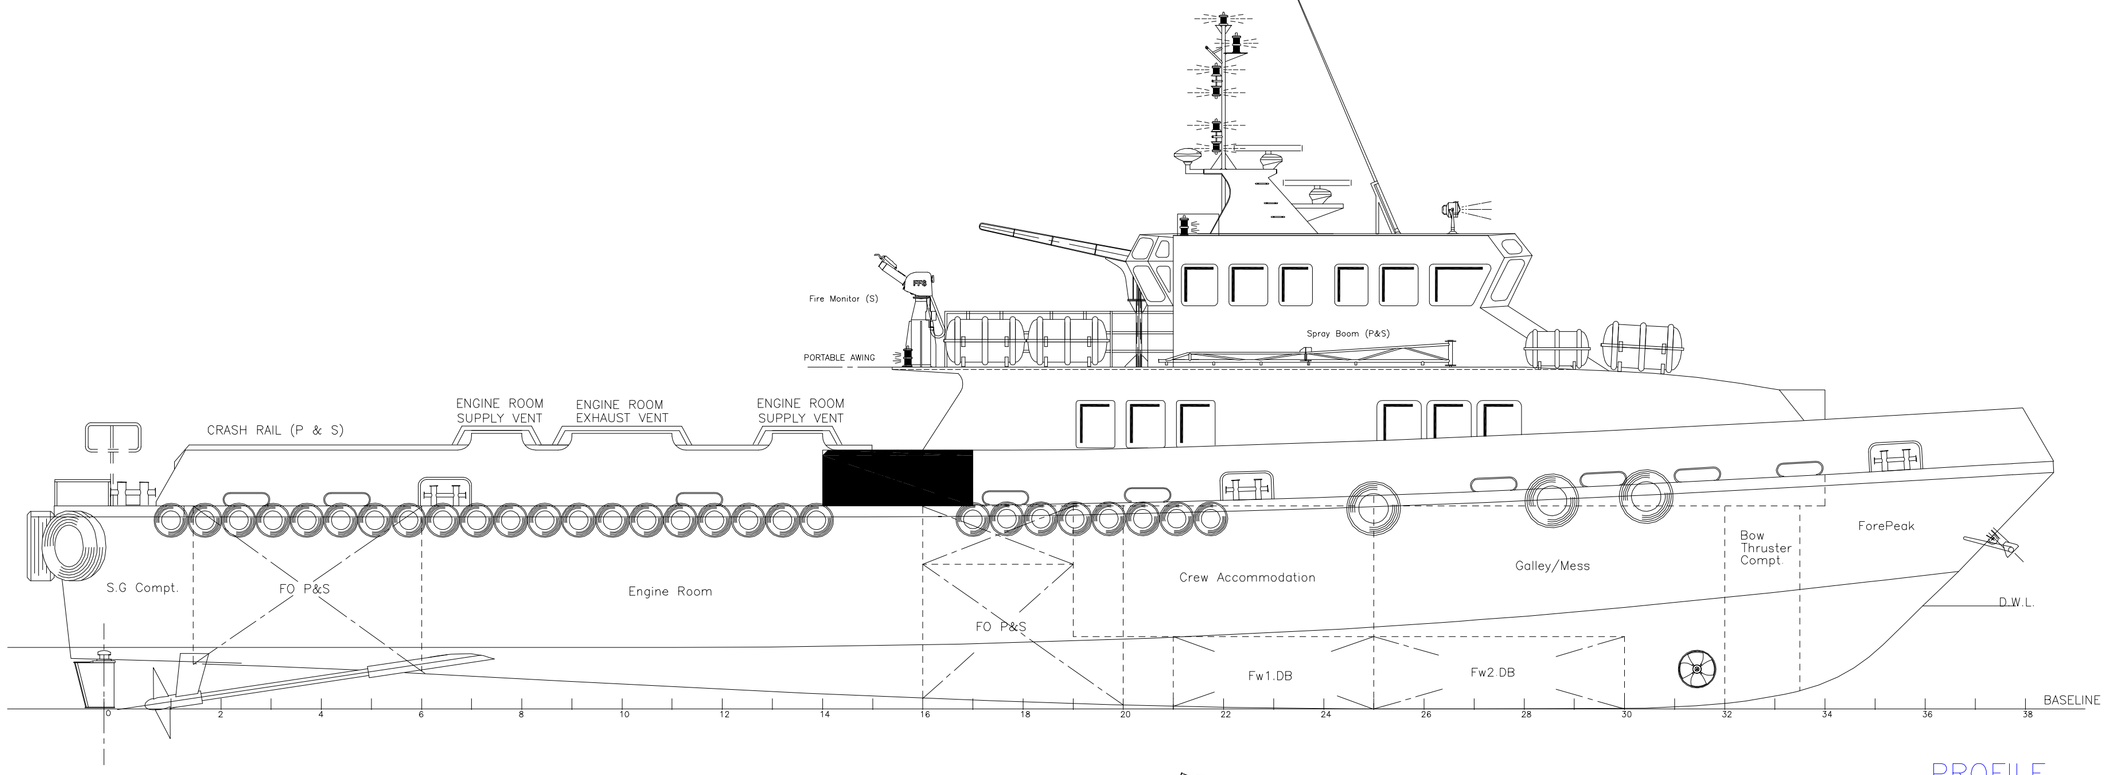

PROFILE

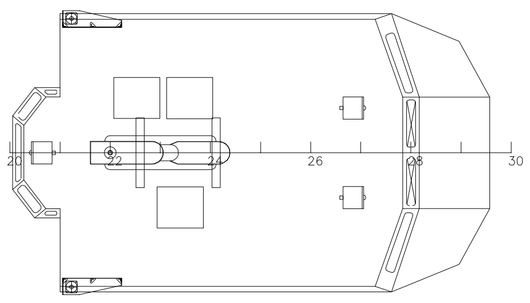

WHEELHOUSE TOP

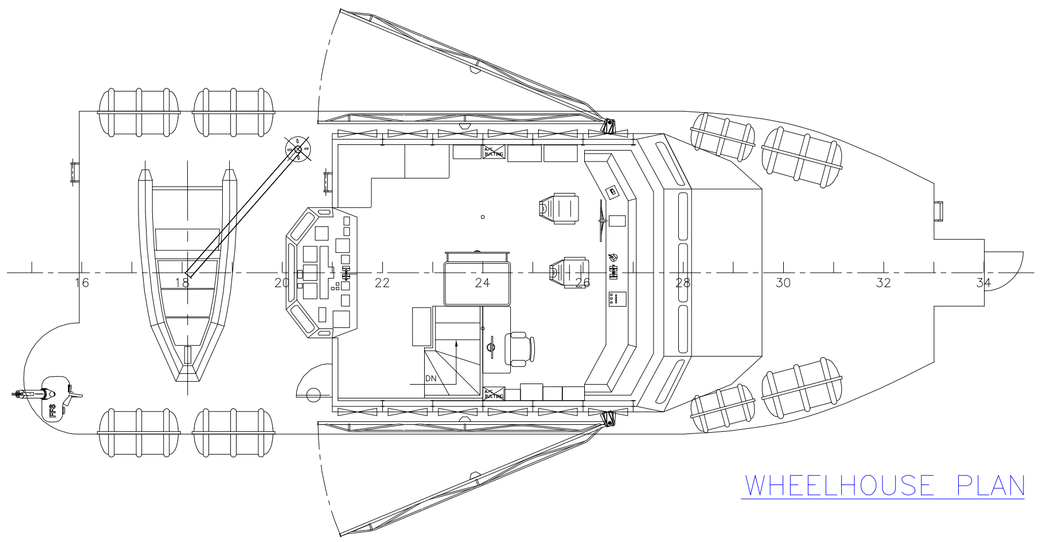

WHEELHOUSE PLAN

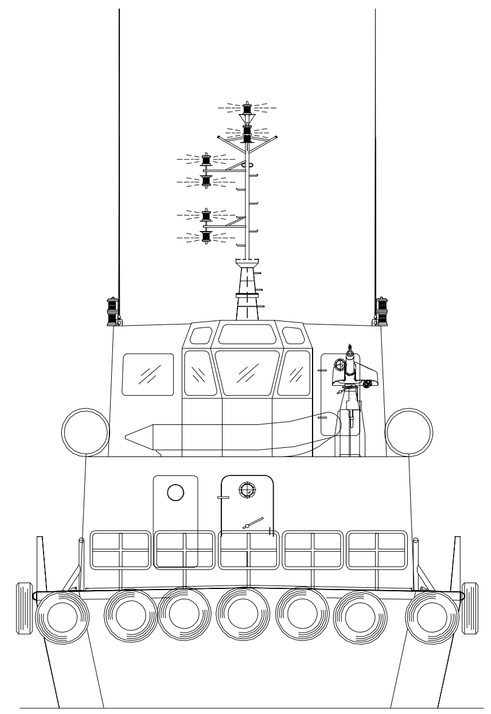

STERN VIEW

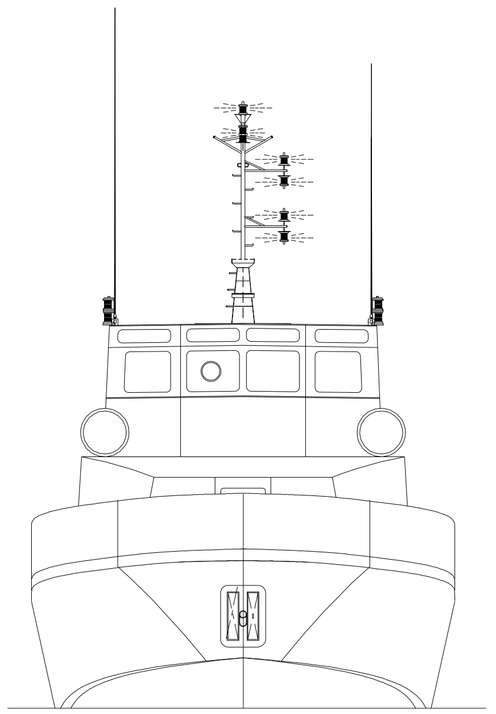

FRONT VIEW

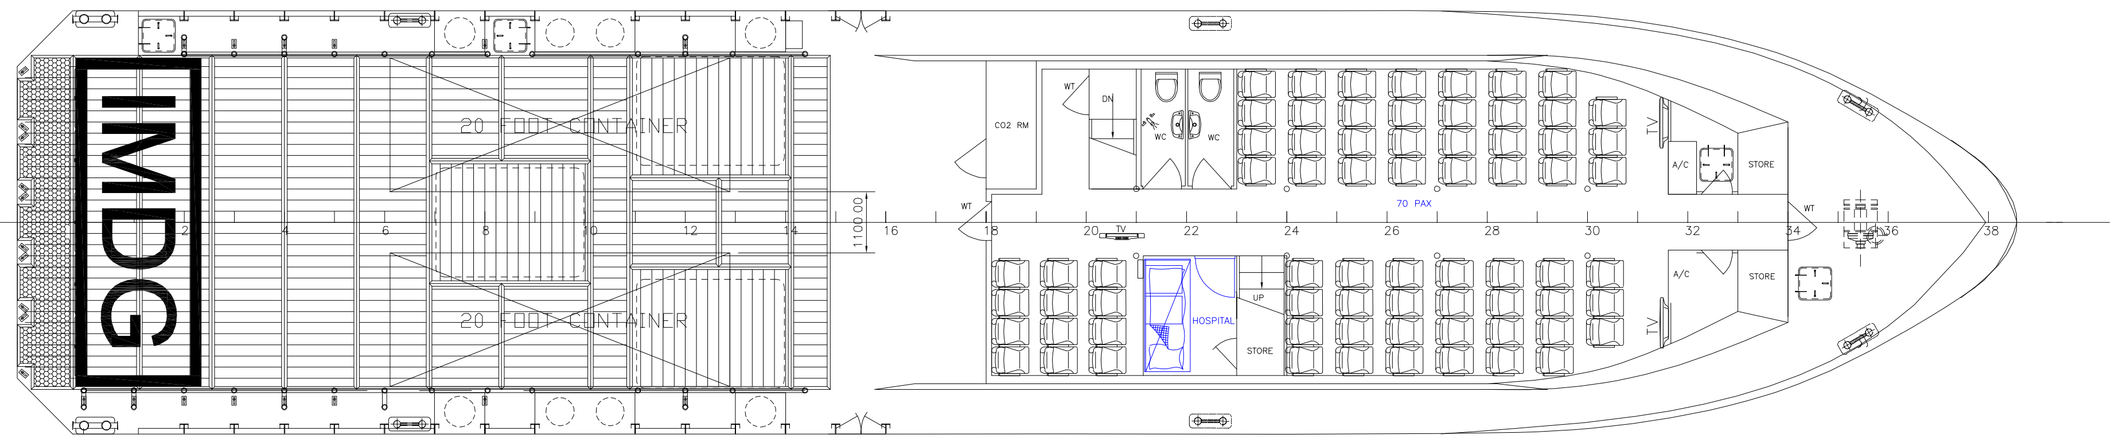

MAIN DECK

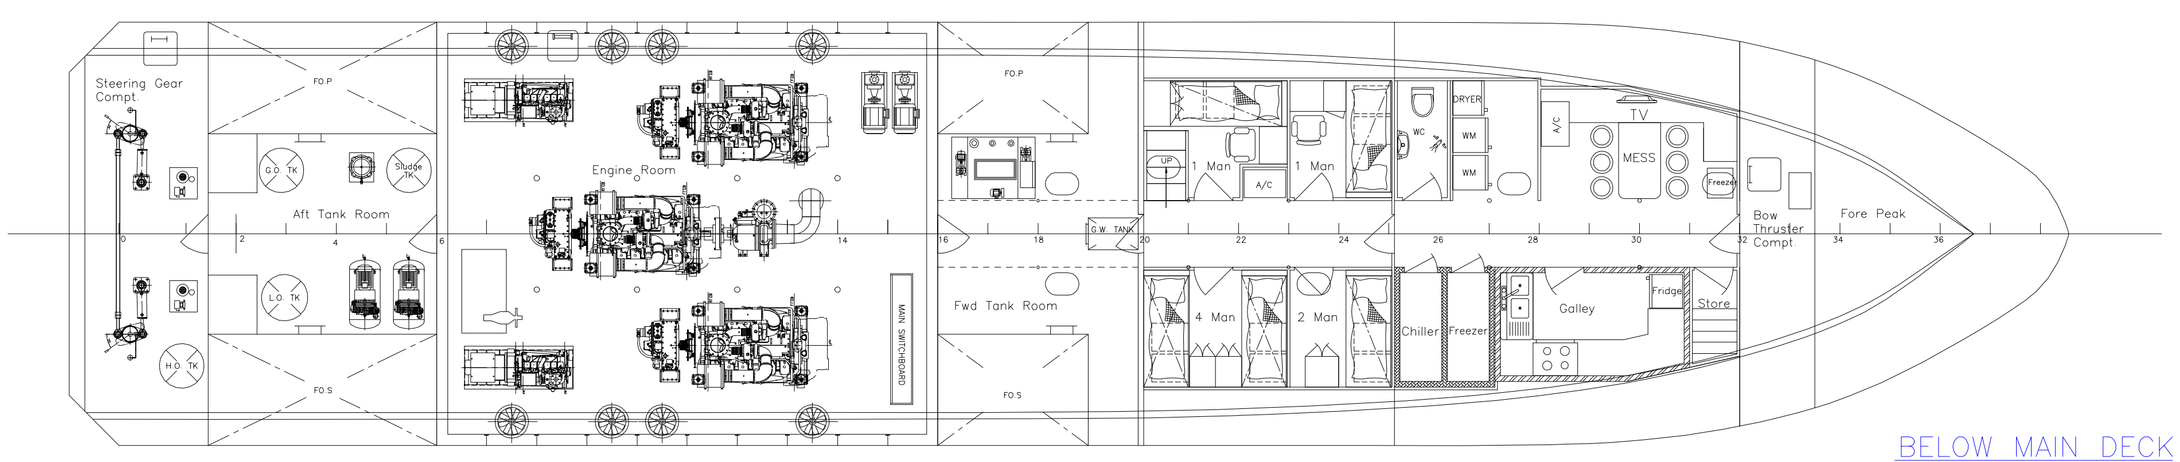

BELOW MAIN DECK

AS-BUILT AS PER CURRENT DATED 16/11/2023	0	YS	MY	16 NOV 2023
DESCRIPTION	REV	DRN BY	CHK BY	DATE

CLIENT:

MICLYN EXPRESS OFFSHORE PTE LTD

Main Office (Singapore) :

10 Hoe Chiang Road,#09 -01/07 Keppel Towers
Singapore 089315
Tel: (65) 65456211 Fax: (65) 6820 0167

www.miclynexpressoffshore.com

This document contains Confidential Proprietary information and shall not be Copied, Reproduced, Used, Transferred to other Documents or Disclosed to others for any purpose unless Authorized by MEO.

TITLE :

GENERAL ARRANGEMENT PLAN

SHIP NAME :

EXPRESS 68

CONTRACT NO.:	DRAWING NO.: MEO-GAP-EX68-001	
DRAWN: TWH	REV.NO.: 0	SCALE: 1:175
CHECKED: MY	SHEET NO.: 1 OF 1	SIZE: A3
APPROVED: YS	DATE: 16 NOV 2022	

FILENAME: GENERAL ARRANGEMENT PLAN