PRINCIPLE PARTICULARS

LENGTH O.A	36.00	M
LENGTH B.P	33.20	M
BREADTH MLD	7.60	M
DEPTH MLD	3.65	M
DESIGN DRAFT	1.88	M
COMPLEMENT	9 CREW	
	60 OFFSHORE WORKERS SEATING	

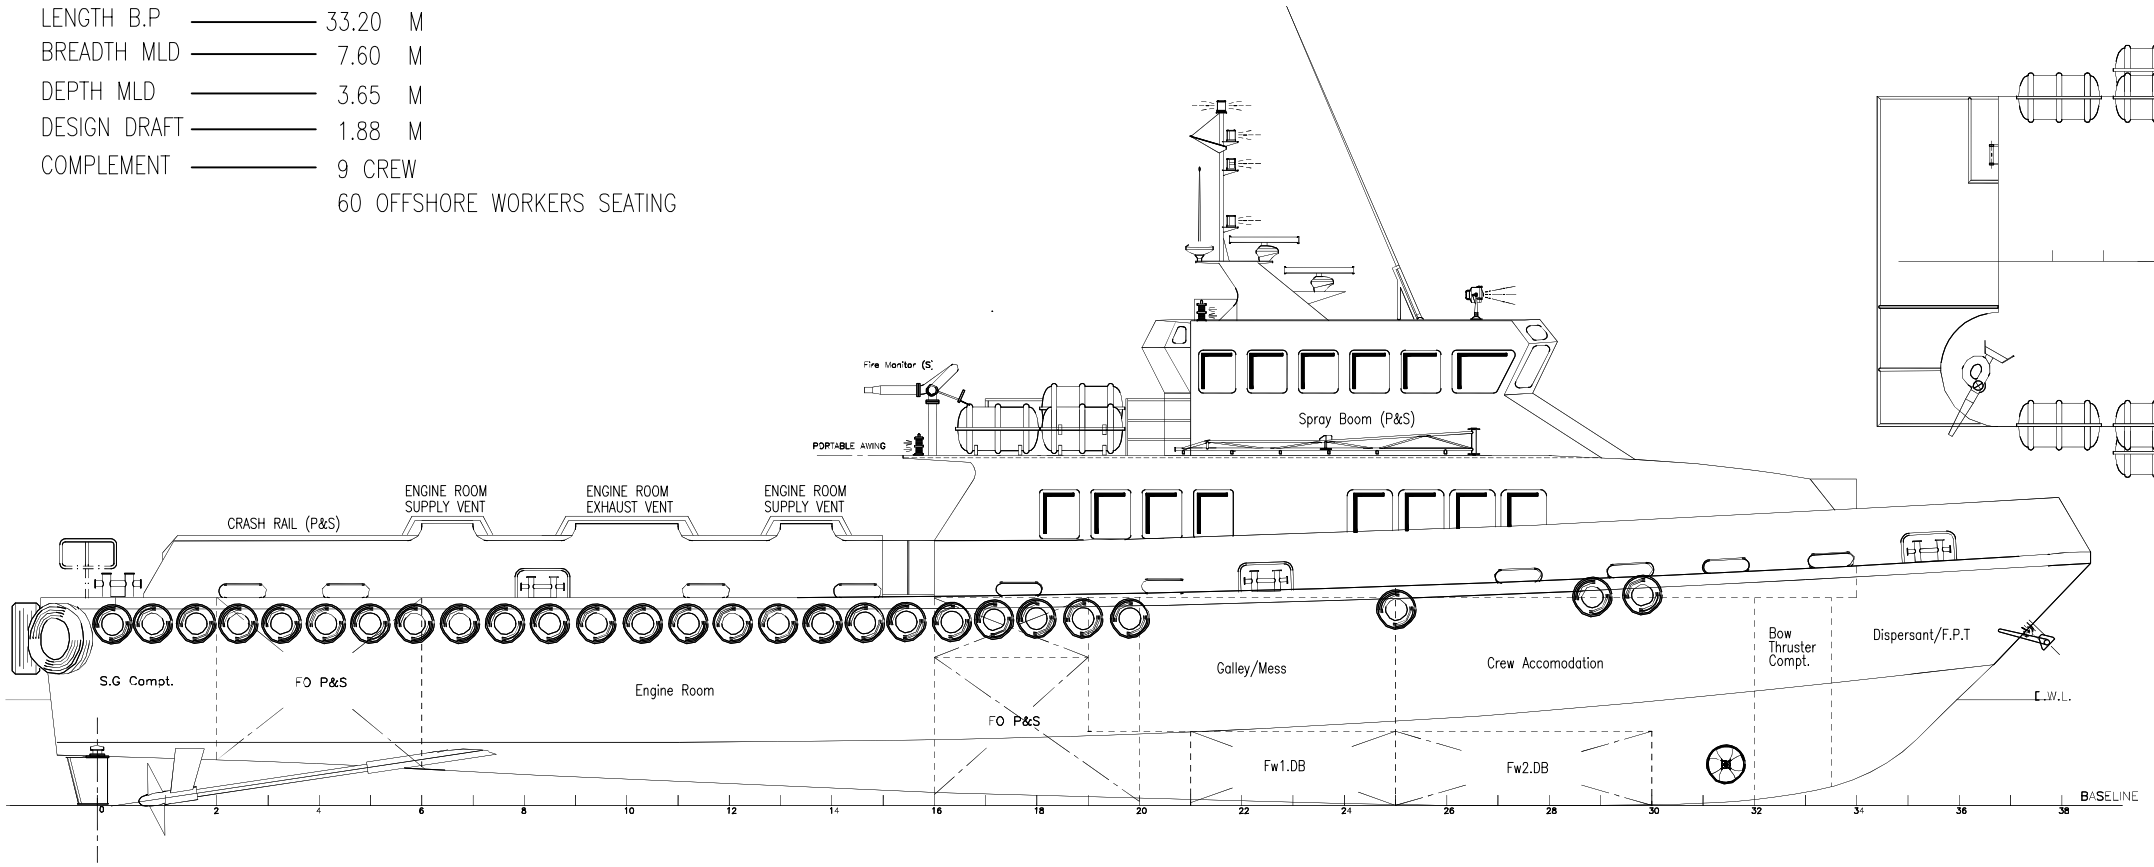

PROFILE

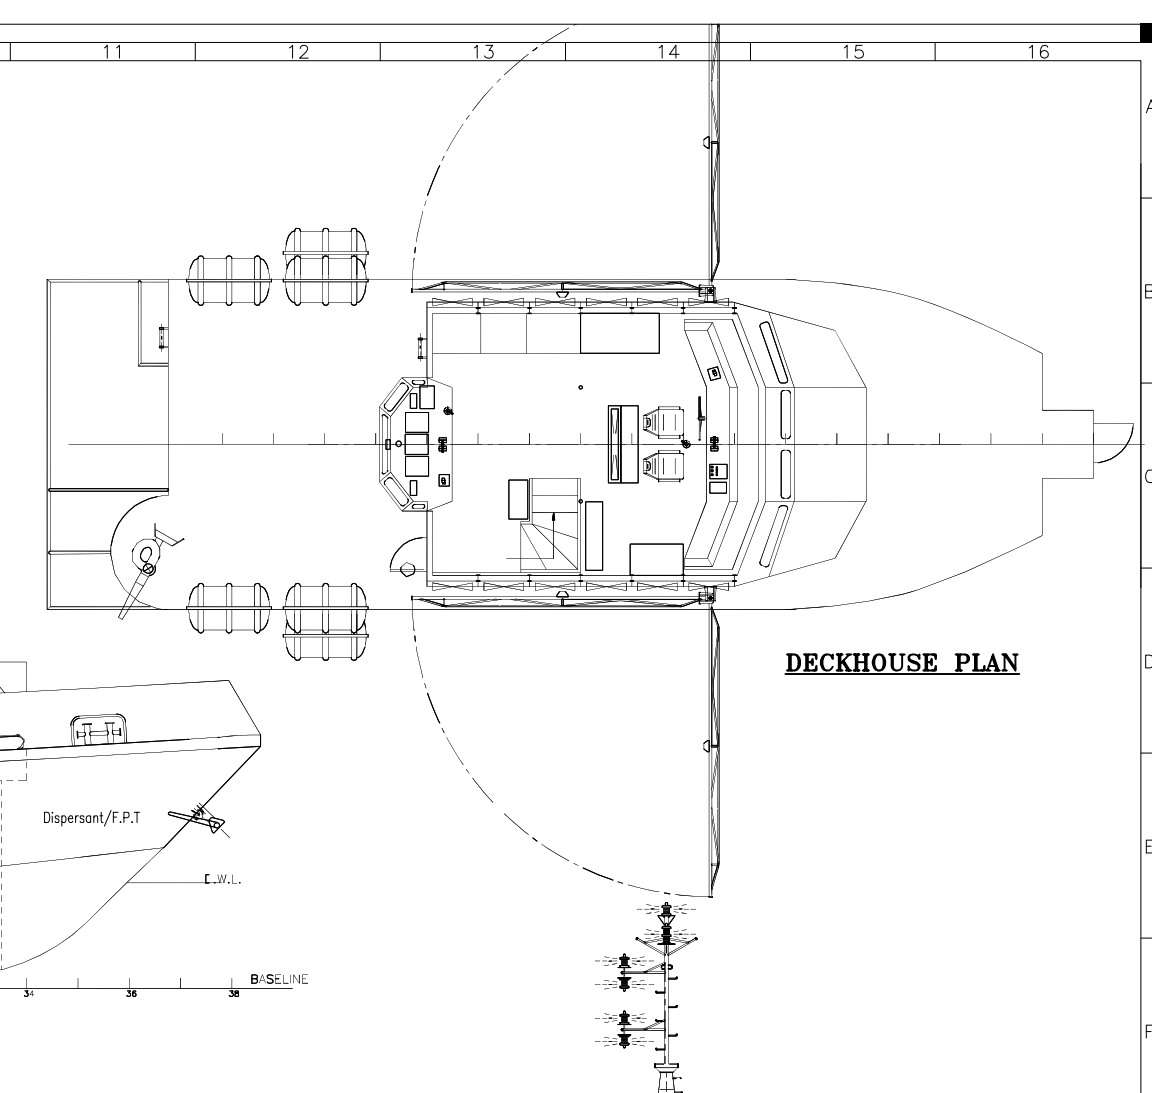

DECKHOUSE PLAN

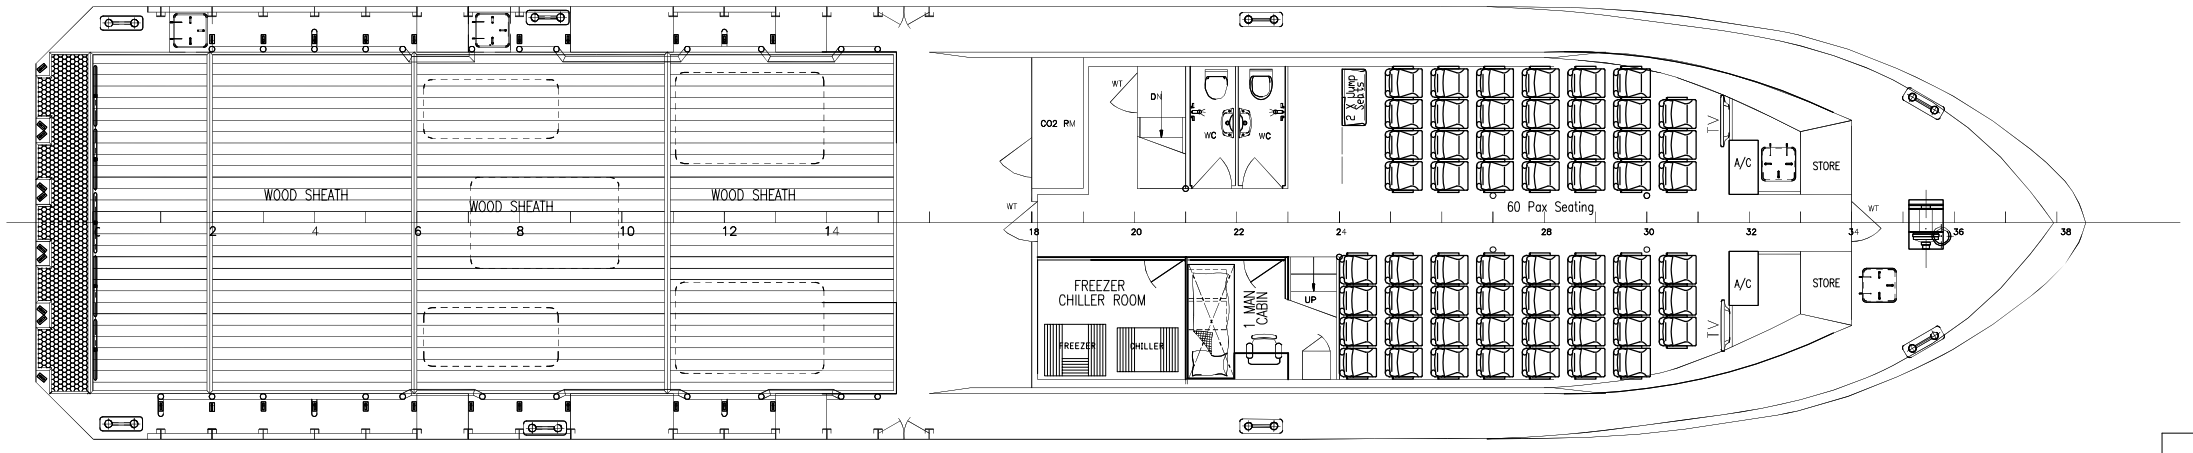

MAIN DECK

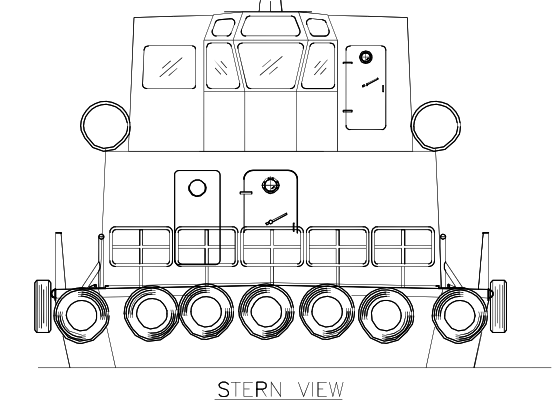

STERN VIEW

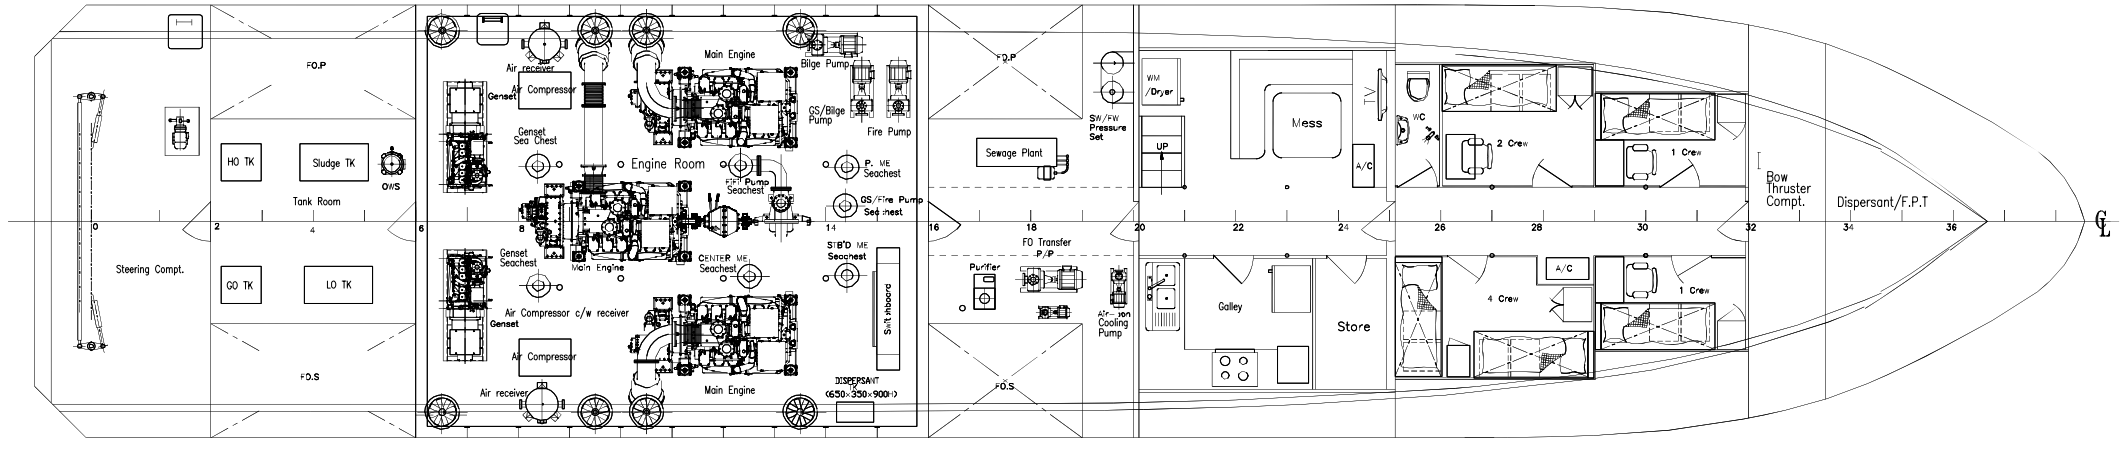

BELOW MAIN DECK

AS BUILT CONDITION	0	YS	MY	11 AUG 2022
DESCRIPTION	REV	DRN BY	CHK BY	DATE

CLIENT:

MICLYN EXPRESS OFFSHORE

36.00m FAST ULITY CRAFT - CREW BOAT

MEO MICLYN EXPRESS OFFSHORE

Main Office (Singapore) :

10 Hoe Chiang Road,#09 -01/07 KeppelTowers
Singapore 089315
Tel: (65) 65456211 Fax: (65) 6820 0167

www.miclynexpressoffshore.com

This document contains Confidential Proprietary Information and shall not be Copied, Reproduced, Used, Transfered to other Documents or Disclosed to others for any purpose unless Authorized by MEO.

TITLE : GENERAL ARRANGEMENT			
SHIP NAME : UNI EXPRESS 20			
CONTRACT NO.:	DRAWING NO.: MEO-UE20-HG-001		
DRAWN: YS	REV.NO.: 0	SCALE: 1:30	
CHECKED: MY	SHEET NO.: 1 OF 1	SIZE: A3	
APPROVED: THW	DATE: 11 AUG 2022		

FILENAME: GENERAL ARRANGMENT